



Wisconsin Department of Transportation

September 4, 2025

Division of Transportation Systems Development

Bureau of Project Development
4822 Madison Yards Way, 4th Floor South
Madison, WI 53705

Telephone: (608) 266-1631
Facsimile (FAX): (608) 266-8459

NOTICE TO ALL CONTRACTORS:

Proposal #07: 1060-27-74, WISC 2025597
I-94 East West, Early East Leg
30th Street to 25th Street
IH 94
Milwaukee County

Letting of September 9, 2025

This is Addendum No. 03, which provides for the following:

Special Provisions:

Revised Special Provisions	
Article No.	Description
7	Holiday and Special Event Restrictions.
206	Drilled Foundation Shaft 34.65-Inch, Item SPV.0060.4100; Drilled Foundation Shaft 59.06-Inch, Item SPV.0060.4110.

Schedule of Items:

Revised Bid Item Quantities					
Bid Item	Item Description	Unit	Proposal Total Prior to Addendum	Proposal Quantity Change (-)	Proposal Total After Addendum
204.0210	Removing Manholes	Each	14	-2	12
204.0245.0003	Removing Storm Sewer 18-Inch	LF	238	-120	118
204.0250	Abandoning Manholes	Each	1	3	4
204.0291.S	Abandoning Sewer	CY	5	7	12
511.1200.0010	Temporary Shoring (R-40-10)	SF	3,420	580	4,000

Plan Sheets:

Revised Plan Sheets	
Plan Sheet	Plan Sheet Title (brief description of changes to sheet)
39	Construction Detail – Revised length of 42-Inch CBSS barrier in Type S2 transition
79	Plan Details – Revised callouts at Concrete Barrier Type S2 Transition
134	Existing Storm Sewer Removals – Revised existing abandoning manhole and sewer location. Added abandoning sewer and abandoning manhole notes
136	Storm Sewer Staging – Revised stage note for manhole under 27 th St bridge
149-150	Storm Sewer Plan and Profile – Revised manhole under 27 th St bridge
280	Traffic Control –Additional details for partial wall removal included
281	Traffic Control – Revised limits of B-40-57 wingwall removal and shoring left in place
301	Traffic Control – Revised name of construction details referenced
377	Miscellaneous Quantities – Revised Concrete Barrier Type S2 Transition station range
392-395	Miscellaneous Quantities – Revised Removing Manholes, Abandoning Manholes, Storm Sewer Pipe Removals, Abandoning Sewer, and Reconnecting Storm Sewer tables
399	Miscellaneous Quantities – Revised station/offset for manhole
404	Miscellaneous Quantities – Temporary Shoring (R-40-10) quantity revised
763	Structures Plan (B-40-1083) – Added minimum removal limits elevation
829	Structures Plan (R-40-761) – Removed wall system note
852	Structures Plan (R-40-761) – Revised MSE panel embedment
865	Structures Plan (R-40-767) – Removed wall system note
866	Structures Plan (R-40-767) – Revised MSE panel embedment
867	Structures Plan (R-40-767) – Revised MSE panel embedment
901-903	Cross Sections – Revised location of eastbound barrier location

The responsibility for notifying potential subcontractors and suppliers of these changes remains with the prime contractor.

Sincerely,

Mike Coleman

Proposal Development Specialist
Proposal Management Section

ADDENDUM NO. 03

1060-27-74

September 4, 2025

Special Provisions

7. Holiday and Special Event Restrictions.

*Add the following paragraph after paragraph 1 in section titled **Freeway Special Event Restrictions**:*

Special event work restrictions do not apply to the Onetime Only Continuous Closure of I-94 EB for girder setting as defined in the Traffic article of the project Special Provisions.

**206. Drilled Foundation Shaft 34.65-Inch, Item SPV.0060.4100;
Drilled Foundation Shaft 59.06-Inch, Item SPV.0060.4110.**

*Replace the last sentence in section titled **B.1 General** with the following:*

In the event that the provisions of other specification clauses causes ambiguity or conflict with these special provisions, the stricter requirement shall apply unless otherwise accepted by the engineer.

*Replace the first two paragraphs in section titled **B.2 Equipment** with the following:*

Equipment used for excavation, drilling, and cleaning operations shall utilize full-depth temporary casing, installed using an overhead rotary drill rig to excavate inside the casing. Temporary casing installation shall be advanced a minimum of 5 feet ahead of any excavation inside the casing at all times until the shaft tip elevation is reached. The overhead rotary drill rig shall have adequate capacity; including power, torque, and down thrust to install and extract the full depth temporary casing to a depth equal to the maximum depth of the drilled shafts shown in the plans plus 5 feet of the maximum shaft length determined by the test core required in C.3.6.8. The overhead rotary drill rig shall have adequate capacity, including power, torque and down thrust to excavate a hole within the casing to a depth equal to the maximum shaft length determined by the test core required in C.3.6.8 plus 5 feet. Anticipate and make available at the job site all equipment necessary and essential to penetrate soft and hard soils (including bedrock), as well as cobbles and boulders and unidentified man-made obstructions, during the construction of the drilled shafts.

A standby oscillator must be available on site in the event the overhead rotary drill rig is unable to reliably install or extract the temporary casing for drilled shafts at Piers 1, 2, and 3 of B-40-1083. The standby oscillator must be capable of installing and extracting the full depth temporary casing by means of rotational or oscillatory motion and advancing the casing a minimum of 5 feet ahead of the excavation inside the casing until the shaft tip elevation is reached. A standby oscillator for drilled shaft installation at the north abutment of B-40-1083 is not required. No excavation ahead of the casing is permitted without the engineer's approval. Installation or removal of temporary casing by impact driving or vibration is not permitted. Advancing and installing the temporary casing by means of excavation ahead of the casing is not permitted.

*Replace the table in section titled **C.3.8 CSL Access Tube Installation** with the following:*

Drilled Shaft Diameter	Number of CSL Tubes	Tube Spacing
34.65-inches	4 minimum	As shown in plans
59.06-inches	5 minimum	As shown in plans

Schedule of Items

Attached, dated September 4, 2025, are the revised Schedule of Items Pages 2, 3, and 7.


Plan Sheets

The following 8½ x 11-inch sheets are attached and made part of the plans for this proposal:


Revised: 39, 79, 134, 136, 149-150, 280-281, 301, 377, 392-395, 399, 404, 763, 829, 852, 865-867, 901-903.

END OF ADDENDUM

Addendum No. 03
ID 1060-27-74
Revised Sheet 39
September 4, 2025

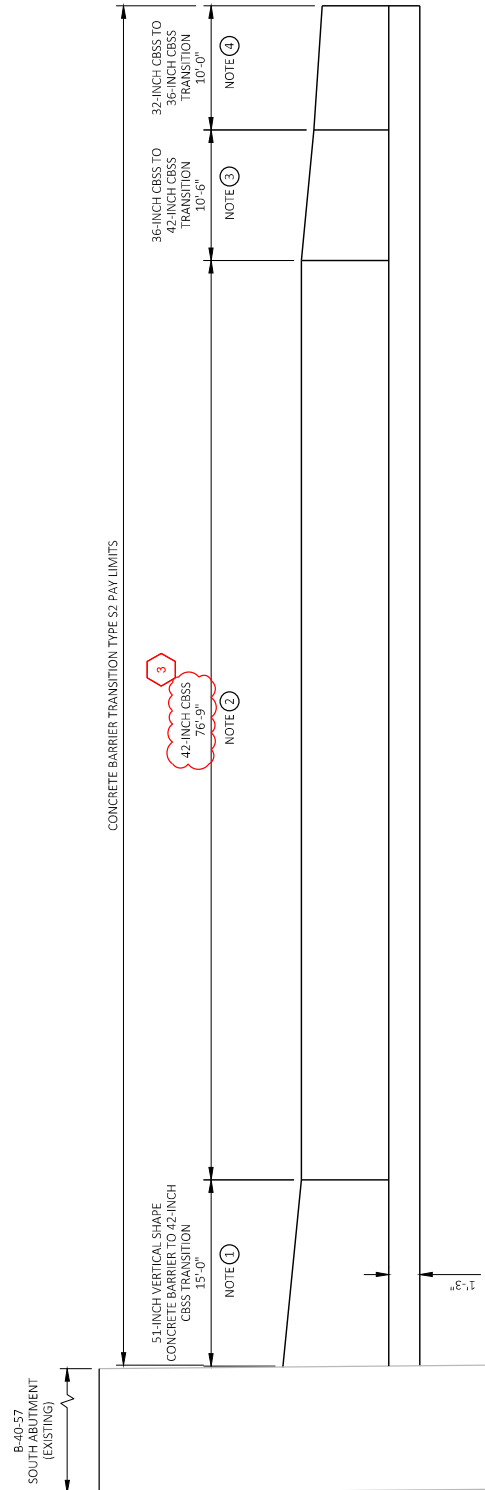

ELEVATION VIEW

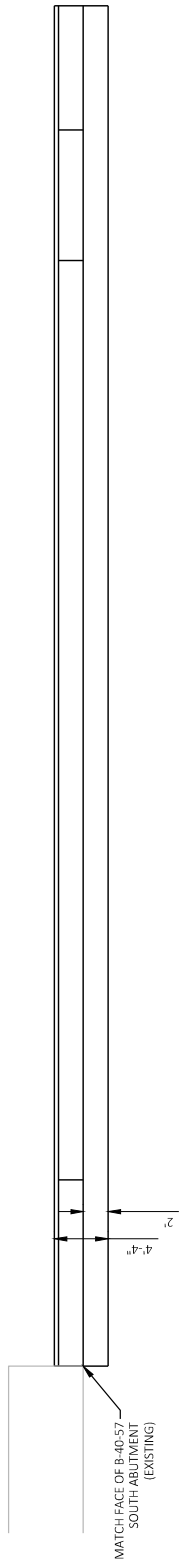


PLAN VIEW

- NOTES
- MODIFY 848 STEEL NEAR INLETS PER SDD "SINGLE SLOPE ROADSIDE RETAINING WALL - PLACEMENT AND DRAINAGE"
 - SEE SDD "51-INCH VERTICAL SHAPE CONCRETE BARRIER TO 42-INCH SINGLE SLOPE CONCRETE BARRIER TRANSITION FOR ADDITIONAL INFORMATION."
 - FOOTING REQUIRED THROUGH LIMITS OF 42-INCH CBSS. SEE SDD "CONCRETE BARRIER SINGLE SLOPE (CBSS)" FOR ADDITIONAL INFORMATION.
 - SEE SDD "36" SINGLE SLOPE CONCRETE BARRIER TO 42" SINGLE SLOPE CONCRETE BARRIER HEIGHT TRANSITION" FOR ADDITIONAL INFORMATION.
 - SEE SDD "32" SINGLE SLOPE CONCRETE BARRIER TO 36" SINGLE SLOPE CONCRETE BARRIER HEIGHT TRANSITION" FOR ADDITIONAL INFORMATION.

CONCRETE BARRIER TRANSITION TYPE S2 DETAIL

PROJECT NO: 1060-27-74	HWY: IH 94	COUNTY: MILWAUKEE	CONSTRUCTION DETAILS	SHEET 39	E
FILE NAME: C:\USERS\DAUMANN\DOCS\WISDOT\10602703\PROJECT FILES\CORE EAST SEGMENT\10602774\SHEETS\03 TYPES\DETAILS\10602709EA-02.001-CD.DWG	PLOT DATE: 9/22/2025 3:43 PM	PLOT BY: DAN BAUMANN	PLOT NAME: 1 IN=10 FT	WISDOT/CADDS SHEET 42	

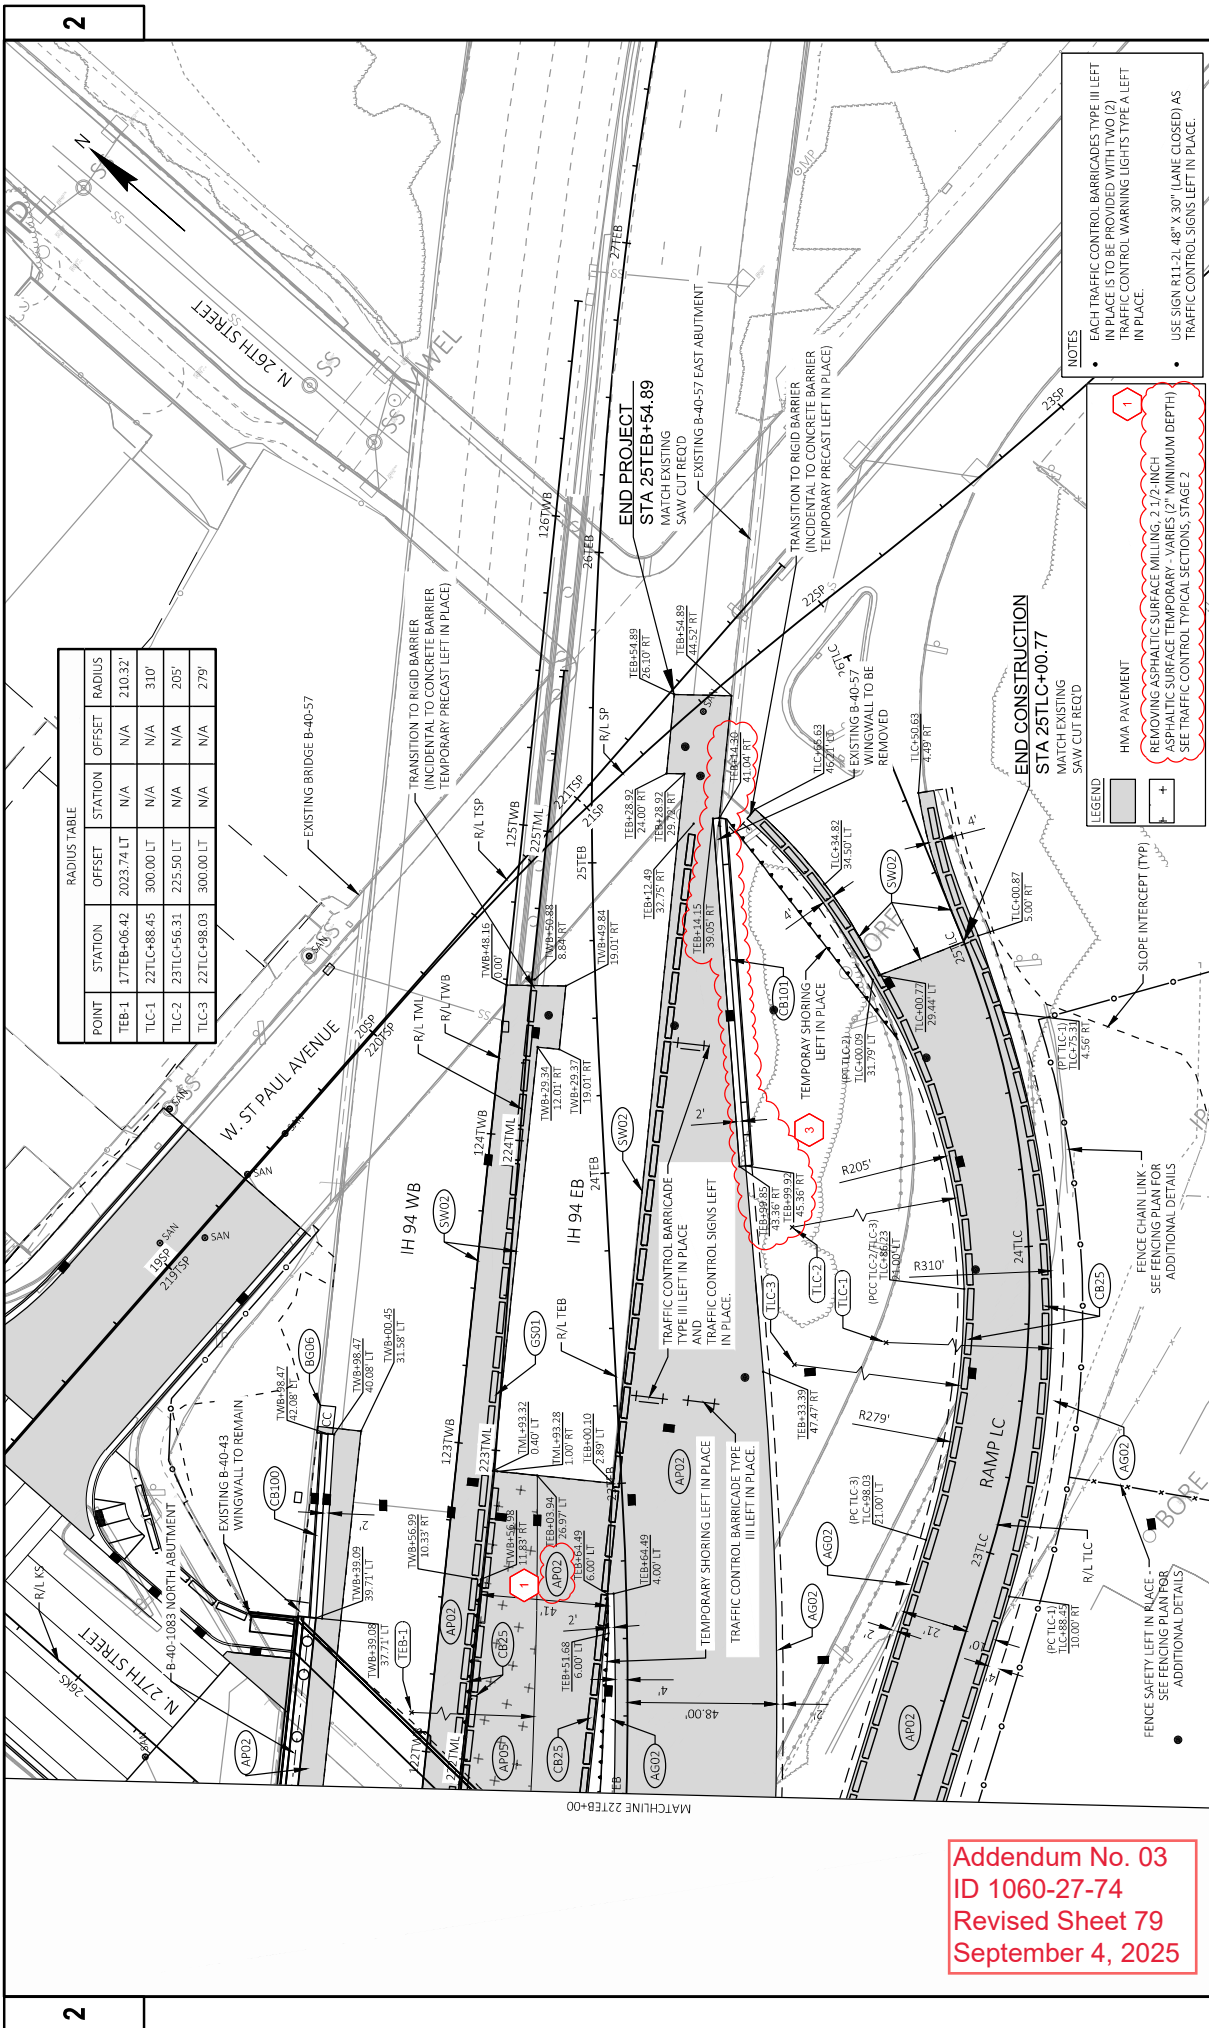

RADIUS TABLE				
POINT	STATION	OFFSET	STATION	RADIUS
TEB-1	177EB+06.42	2023.74 LT	N/A	210.32'
TLC-1	22TLC+88.45	300.00 LT	N/A	310'
TLC-2	23TLC+56.31	225.50 LT	N/A	205'
TLC-3	22TLC+98.03	300.00 LT	N/A	279'

- NOTES
- EACH TRAFFIC CONTROL BARRICADES TYPE III LEFT IN PLACE IS TO BE PROVIDED WITH TWO (2) TRAFFIC CONTROL WARNING LIGHTS TYPE A LEFT IN PLACE.
 - USE SIGN R11-2L 48" X 30" (LANE CLOSED) AS TRAFFIC CONTROL SIGNS LEFT IN PLACE.

LEGEND

HMA PAVEMENT

REMOVING ASPHALT/C SURFACE MILLING 2.17 INCH DEPTH MINIMUM DEPTH SEE TRAFFIC CONTROL TYPICAL SECTIONS, STAGE 2


SLOPE INTERCEPT (TYP)

Addendum No. 03
ID 1060-27-74
Revised Sheet 79
September 4, 2025


[illegible]

- 1) DSVP CONNECTS TO MAINLINE STRUCTURES.
- 2) VARIOUS PIPE ARE CROSSING TEMPORARY SHORING.

PROJECT NO:	1060-27-74	HWY: IH 94	COUNTY: MILWAUKEE	STORM SEWER STAGING PLAN: IH 94 TML	E
FILE NAME:	C:\USER\BANDOGGE\AC\CDOS\WISDOT\1060-27-74\PROJECT FILES\EAST SEGMENT\1060-27-74\SHEET\TWS\TWSANDSTAGINGS\DRAWING\022502-55-TML - STAGINGPLAN.DWG				
LAYOUT NAME:	CDOS - EAST SEGMENT\1060-27-74\SHEET\TWS\TWSANDSTAGINGS				
PLUT DATE:	9/2/2025 1:33 PM		PLUT BY:	BRANDON DOOSGE, EIT	
PLUT SCALE:	1 IN.=100 FT				
				SHEET	136
WISDOT\CDOS\ SHEET 41					

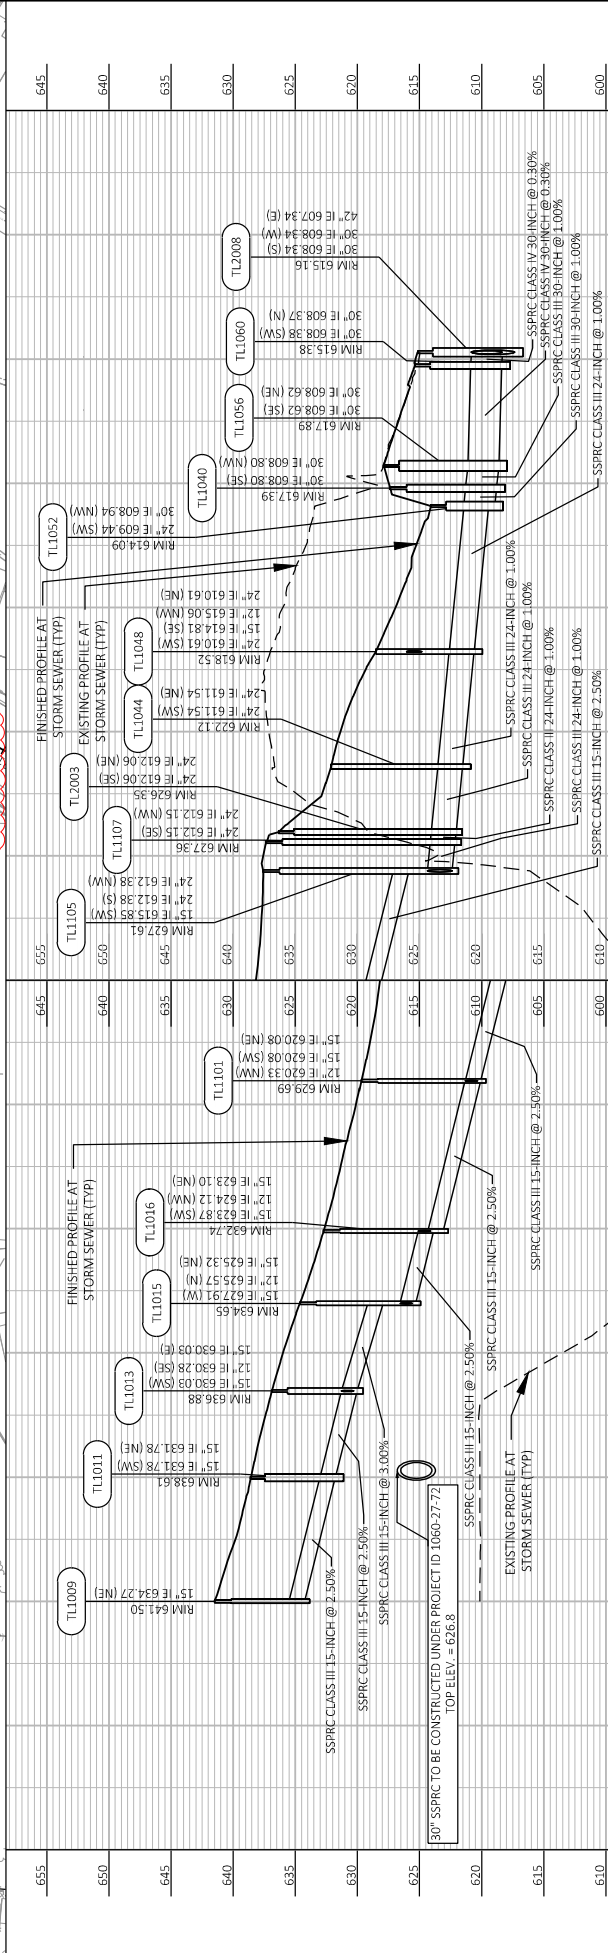

PROJECT NO:	1060-27-74	HWY:	IH 94	COUNTY:	MILWAUKEE	STORM SEWER PLAN AND PROFILE:	IH 94 TEB	SHEET	149
FILE NAME:	C:\USER\BAMOND\DWG\CADDCOCS\WISDOT\JAG02703\PROJECT FILES\EAST SEGMENT\I190774\SHEETS\02-SSE-TML.DWG								
PLOT DATE:	9/2/2025 11:19 PM		PLOT BY:	BRANDON DOOGLE, JTT					
PLOT SCALE:	1 IN=100 FT								
WISDOT CADD SHEET 41									

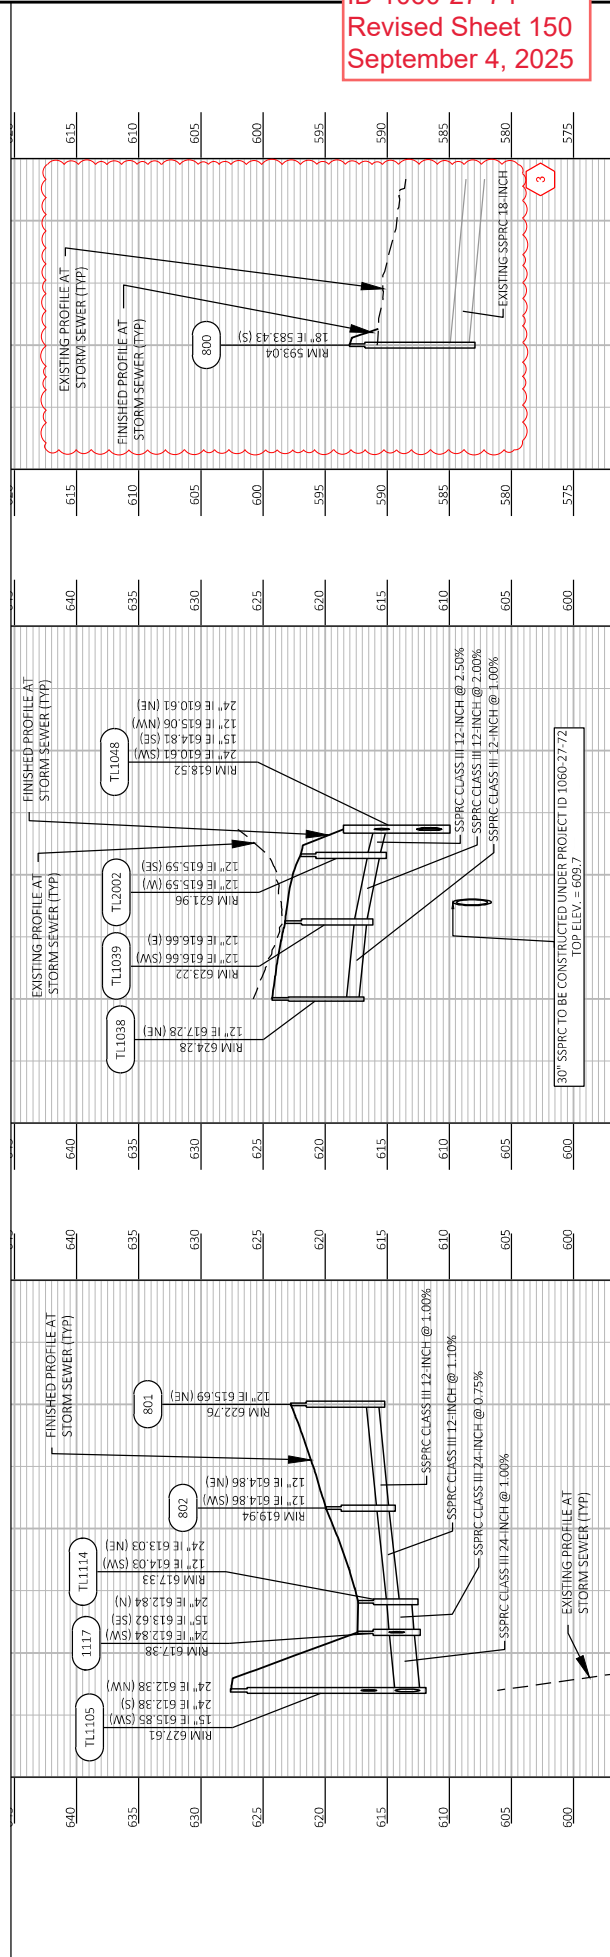

NOTES:

- 1) EXISTING WALL CROSS SECTION SHOWN ON DETAIL IS APPROXIMATE.
- 2) DO NOT REMOVE ANY PORTION OF EXISTING WALL R-40-10 PRIOR TO PLACEMENT OF MINIMUM REQUIRED EMBANKMENT

3

R/L AT EX. R-40-10 FRONT FACE OF WALL

R/L

2' BELOW FUTURE PROJECT 1060-27-72 SUBGRADE

17' TYP

10' MIN

30'

3:1

MINIMUM REQUIRED EMBANKMENT AT TIME OF PARTIAL WALL REMOVAL

STAGE 1B EB TRAFFIC CONFIGURATION

LANE 1

LANE 2

TEMPORARY SHORING EXPOSED FACE

EXISTING WALL R-40-10 PARTIAL REMOVAL LIMITS

EXISTING WALL R-40-10

FUTURE IH 94 PROJECT 1060-27-72 (BY OTHERS)

PROJECT NO: 1060-27-74		HWY: IH 94		COUNTY: MILWAUKEE	TRAFFIC CONTROL - TEMPORARY SHORING (EX. R-40-10 PARTIAL REMOVAL)		SHEET 280
PLAN NAME: C:\USERS\PSCHER\00\ACAD\DWG\00\0001\0002\703\PROJECT FILES CORE EAST SEGMENT\0002\709\LA-023064-TC.DWG PLOT DATE: 9/2/2025 10:54 AM PLOT BY: RESHEL KYLE PLOT NAME:				PLOT SCALE: 1 IN=100 FT		WSDOT/CADSW SHEET 42	

STATION	FINISHED GRADE ELEV	EXISTING GROUND ELEV
24+37.00	629.42	631.11
24+67.00	623.99	630.94
24+97.00	619.58	631.11
25+27.00	615.12	633.58
25+29.48	614.75	632.87

P.I. STATION	NORTHING	EASTING	DISTANCE	BEARING
24+37.00	298037.92	594077.72	90.15	N11°14'29.17"E
25+27.15	298126.35	594095.29	2.33	N35°11'49.73"E
25+29.48	298128.24	594093.95		

P.I. STATION	NORTHING	EASTING	DISTANCE	BEARING
24+37.00	298037.92	594077.72	90.15	N11°14'29.17"E
25+27.15	298126.35	594095.29	2.33	N35°11'49.73"E
25+29.48	298128.24	594093.95		




Addendum No. 03
ID 1060-27-74
Revised Sheet 281
September 4, 2025

TEMPORARY SHORING LEFT IN-PLACE TO BE PAID UNDER BID ITEM 511.12000.0057 "TEMPORARY SHORING LEFT IN-PLACE (B-40-57)".
WINGWALL REMOVAL TO BE PAID UNDER BID 203.0220 "REMOVING STRUCTURE (B-40-57)".
VIBRATION CONTROL AND MONITORING OF THE EXISTING CITY OF MILWAUKEE COMBINED SEWER LINE IS TO BE PAID UNDER BID ITEM SPV 00660.0200 "VIBRATION CONTROL AND MONITORING OF 12-INCH COMBINED SEWER".
SEE GEOTECHNICAL INVESTIGATION INFORMATION FOR SOIL BORING DATA.



TYPICAL SECTION
(LOOKING SOUTH)

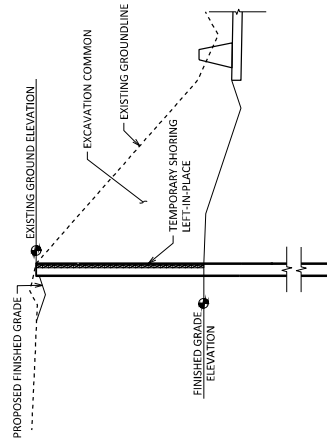

CONCRETE BARRIER TRANSITION ITEMS

	STAGE	ROADWAY	STATION	TO	STATION	OFFSET	EACH	TYPE S1	TRANSITION	BARRIER	CONCRETE	COUNT
							EACH	TYPE S2				
1	MAINLINE <u>JH 94 EB</u>											
			23TEB+99	-	25TEB+14	RT	--					1
	SUBTOTAL						--					1
3	MAINLINE <u>JH 94 WB</u>											
			122TWB+39	-	122TWB+99	LT	1	--				
	SUBTOTAL						1	--				
	TOTALS						1					1

Addendum No. 03
ID 1060-27-74
Revised Sheet 377
September 4, 2025

REMOVING MANHOLES				REMOVING INLETS			
204.0210	204.0220						
REMOVING MANHOLES	REMOVING INLETS						
STAGE	ROADWAY	STATION	OFFSET	STATION	OFFSET	INLETS EACH	
1A	MAINLINE RETAINING WALL R-40-761	419EW-92 419EW-90	136' RT 230' RT	54TEB-93.58 21TEB-98.74 22TEB-99.59	67.45' RT 32.68' RT 43.74' RT	1 1 1	
SUBTOTAL							
1B	MAINLINE INTERIM 94EB			22TEB-59.51	40.84' RT	1	
SUBTOTAL						4	
2	MAINLINE INTERIM 94WB	24TEB-66.45	32.55' RT	217TML-46.43	39.78' RT	1	
SUBTOTAL						1	
3	MAINLINE INTERIM 94WB	115TW-99-30.70	6.04' RT				
SUBTOTAL							
3	MAINLINE INTERIM 94WB			113TWB-80.11 113TWB-80.22 117TWB-18.14 117TWB-21.13 117TWB-29.96 117TWB-30.87 117TWB-31.29 120TWB-05.57 120TWB-14.66 121TWB-14.66 121TWB-57.95 121TWB-62.61 121TWB-71.69 121TWB-77.47 121TWB-76.79 121TWB-33.75	6.10' RT 11.07' RT 6.28' RT 1.08' RT 2.08' RT 6.04' RT 11.52' RT 13.92' RT 11.45' RT 11.45' RT 13.48' RT 0.15' LT 2.18' RT 6.24' RT 6.39' RT 12.13' RT	1 1 1 1 1 1 1 1 1 1 1 1 1 1 1 1 15	
SUBTOTAL							
3	MAINLINE INTERIM 94WB			121TWB-62.59 122TWB-77.41	41.44' LT 41.80' LT	1 1	
SUBTOTAL						2	
3	RAMPS RAMP TID						
SUBTOTAL							
3	LOCAL ROADS 217 PAUL AVENUE			101TD-17.28 102TD-49.98 103TD-52.90	16.36' RT 13.42' RT 22.87' RT	1 1 1	
SUBTOTAL						3	
3	LOCAL ROADS 217 PAUL AVENUE			115P-34.73 125P-43.68 135P-37.93 145P-40.36 155P-36.93 175P-26.95 175P-30.52	54.86' RT 30.38' LT 30.17' LT 28.03' RT 28.39' LT 27.2' RT	1 1 1 1 1 1	
SUBTOTAL							
3	TEMPORARY ST PAUL AVENUE			218-38.39 218-31.71	43.37' RT 23.99' RT	1 1	
SUBTOTAL							
3	28TH STREET			101H-79.08 111H-52.31 111H-36.57	18.74' RT 44.13' LT 20.49' LT	1 1 1	
SUBTOTAL							
3	27TH STREET			25K5-09.04 27KK-10.93	78.97' LT 23.76' LT	1 1	
SUBTOTAL						13	
TOTAL						38	
* REMOVING COVER PLATE LEFT IN PLACE INCIDENTAL TO REMOVING INLET							

Addendum No. 03
ID 1060-27-74
Revised Sheet 392
September 4, 2025

ABANDONING MANHOLES				ABANDONING MANHOLES			
204.0250	204.0250						
ABANDONING MANHOLES	ABANDONING MANHOLES						
STAGE	ROADWAY	STATION	OFFSET	STATION	OFFSET	MANHOLES EACH	NOTES
1A	MAINLINE RETAINING WALL R-40-761	419EW-93	39' RT			1	FILL WITH BACKFILL SLURRY FROM THE STRUCTURE FLOOR TO THE RIM. BACKFILL SLURRY IS CONSIDERED INCIDENTAL TO ABANDONING THE STRUCTURE.
SUBTOTAL						1	
2	MAINLINE BRIDGE B-40-1083	22KS-47.99 22KS-23.92 22KS-03.84	17' LT 16' LT 21' LT			1 1 1	FILL WITH BACKFILL SLURRY FROM THE STRUCTURE FLOOR TO THE RIM. BACKFILL SLURRY IS CONSIDERED INCIDENTAL TO ABANDONING THE STRUCTURE. FILL WITH BACKFILL SLURRY FROM THE STRUCTURE FLOOR TO THE RIM. BACKFILL SLURRY IS CONSIDERED INCIDENTAL TO ABANDONING THE STRUCTURE.
SUBTOTAL						3	
TOTAL						4	

WISDOT/CADDs SHEET 42

STORM SEWER PIPE REMOVALS																				
STAGE	ROADWAY	STATION	OFFSET	TO	STATION	OFFSET	204.0245.0001		204.0245.0002		204.0245.0003		204.0245.0004		204.0245.0005		204.0245.0006		204.0245.0007	
							REMOVING STORM SEWER	12-INCH	REMOVING STORM SEWER	15-INCH	REMOVING STORM SEWER	18-INCH	REMOVING STORM SEWER	21-INCH	REMOVING STORM SEWER	24-INCH	REMOVING STORM SEWER	27-INCH	REMOVING STORM SEWER	30-INCH
3	MAINLINE INTERM RAMP	121TWB+42.59	41' LT	--	121TWB+42.59	35' LT	---	---	---	---	---	---	---	---	---	---	---	---	---	---
		122TWB+77.32	44' LT	--	122TWB+77.41	42' LT	---	---	---	---	---	---	---	---	---	---	---	---	---	---
		122TWB+77.41	42' LT	--	122TWB+77.41	40' LT	---	---	---	---	---	---	---	---	---	---	---	---	---	---
		SUBTOTAL						9												
3	RAMPS RAMP TID	103TID+52.90	23' RT	--	102TID+46.98	13' RT	---	---	---	---	---	---	---	---	---	---	---	---	---	---
		102TID+49.98	13' RT	--	101TID+17.28	16' RT	---	---	---	---	---	---	---	---	---	---	---	---	---	---
		101TID+17.28	16' RT	--	100TID+17.14	12' LT	---	---	---	---	---	---	---	---	---	---	---	---	---	---
		SUBTOTAL						340												
3	LOCAL ROADS ST. PAUL AVENUE	115P+94.73	55' RT	--	125P+19.77	5' RT	---	---	---	---	---	---	---	---	---	---	---	---	---	---
		125P+43.68	30' LT	--	125P+19.77	5' RT	---	---	---	---	---	---	---	---	---	---	---	---	---	---
		135P+37.93	30' LT	--	135P+28.76	5' RT	---	---	---	---	---	---	---	---	---	---	---	---	---	---
		145P+40.36	28' RT	--	145P+21.24	5' LT	---	---	---	---	---	---	---	---	---	---	---	---	---	---
		175P+26.95	28' LT	--	175P+25.75	5' LT	---	---	---	---	---	---	---	---	---	---	---	---	---	
		175P+30.52	28' RT	--	175P+25.75	5' LT	---	---	---	---	---	---	---	---	---	---	---	---	---	---
					218TSP+38.39	43' RT	--	218TSP+18.63	7' LT	---	---	---	---	---	---	---	---	---	---	---
					219TSP+31.71	24' RT	--	219TSP+39.18	0' LT	---	---	---	---	---	---	---	---	---	---	---
	28TH STREET	101+79.08	19' RT	--	101+51.84	1' RT	---	---	---	---	---	---	---	---	---	---	---	---	---	---
		111+52.31	44' LT	--	111+36.57	20' LT	---	---	---	---	---	---	---	---	---	---	---	---	---	---
		114+58.57	20' LT	--	111+50.48	0' RT	---	---	---	---	---	---	---	---	---	---	---	---	---	---
		SUBTOTAL						33												
	27TH STREET	251S+48.04	30' LT	--	251S+49.04	29' LT	---	---	---	---	---	---	---	---	---	---	---	---	---	---
		251S+49.04	29' LT	--	251S+46.86	5' LT	---	---	---	---	---	---	---	---	---	---	---	---	---	---
		270N+10.93	24' LT	--	270N+17.67	0' LT	---	---	---	---	---	---	---	---	---	---	---	---	---	---
		SUBTOTAL						25												
TOTALS							1,321	1	1	1	118	428	351	276	20					

ABANDONING SEWER

204.0291.5										
STAGE	ROADWAY	STATION	OFFSET	TO	STATION	OFFSET	PIPE ID INCH	INSIDE RADIUS LF	LENGTH LF	ABANDONING SEWER CY
1A	MAINLINE RETAINING WALL R-40.761	419EW+93	39' RT	--	419EW+92	116' RT	12	0.5	76	2
		419EW+90	230' RT	--	429EW+06	260' RT	15	0.63	40	2
		SUBTOTAL								
	1B	MAINLINE INTERM 941B	224TMI+55.35	47' RT	--	224TMI+34.88	4' RT	12	0.5	43
SUBTOTAL									1	
2		MAINLINE BRIDGE B-40.1083	220S+47.99	12' LT	--	220S+23.92	16' LT	18	0.75	24
	220S+23.92		16' LT	--	220S+03.84	21' LT	18	0.75	21	1
	220S+03.84		21' LT	--	218S+03.83	23' LT	18	0.75	63	7
	SUBTOTAL									12
TOTALS										

Addendum No. 03
ID 1060-27-74
Revised Sheet 394
September 4, 2025

RECONNECT STORM SEWER

STAGE	ROADWAY	STRUCTURE ID	STATION	OFFSET	PAGE
1A	MAINLINE TEMPORARY 94EB	1005	15TEB+01.75	45.06' RT	1
		1034	21TEB+80.48	2.94' RT	1
		SUBTOTAL			
1B	MAINLINE TEMPORARY 94EB	2008	225TML+31.70	41.41' RT	1
		E593	225TML+43.55	45.95' RT	1
		SUBTOTAL			
2	MAINLINE INTERIM 94WB	2001	212TML+62.27	2.46' RT	1
		3001	212TML+62.27	4.97' LT	1
		3003	213TML+80.15	36.81' LT	2
		3007	215TML+30.12	30.69' LT	1
		3008	215TML+29.21	3.57' RT	1
		3011	217TML+29.74	8.37' LT	1
		3011	117TWB+28.29	14.42' LT	2
		3018	221TML+63.76	23.79' LT	1
		3030	222TML+78.54	34.39' LT	2
		3023	222TML+78.61	14.37' LT	1
		TEMPORARY 94EB			
		3032	224TML+35.03	2.53' RT	1
3	MAINLINE INTERIM 94WB	3034	224TML+40.94	6.32' RT	1
		800	216+40.83	23.39' LT	1
		SUBTOTAL			
1A	MAINLINE TEMPORARY 94EB	1005	15TEB+01.75	45.06' RT	1
		1034	21TEB+80.48	2.94' RT	1
		SUBTOTAL			
1B	MAINLINE TEMPORARY 94EB	2008	225TML+31.70	41.41' RT	1
		E593	225TML+43.55	45.95' RT	1
		SUBTOTAL			
2	MAINLINE INTERIM 94WB	2001	212TML+62.27	2.46' RT	1
		3001	212TML+62.27	4.97' LT	1
		3003	213TML+80.15	36.81' LT	2
		3007	215TML+30.12	30.69' LT	1
		3008	215TML+29.21	3.57' RT	1
		3011	217TML+29.74	8.37' LT	1
		3011	117TWB+28.29	14.42' LT	2
		3018	221TML+63.76	23.79' LT	1
		3030	222TML+78.54	34.39' LT	2
		3023	222TML+78.61	14.37' LT	1
		TEMPORARY 94EB			
		3032	224TML+35.03	2.53' RT	1
3	MAINLINE INTERIM 94WB	3034	224TML+40.94	6.32' RT	1
		800	216+40.83	23.39' LT	1
		SUBTOTAL			

RECONNECT STORM SEWER

STAGE	ROADWAY	STRUCTURE ID	STATION	OFFSET	PAGE
3	RAMPS RAMP 1D	E576	1007ID+17.24	11.46' LT	1
		SUBTOTAL			
3	LOCAL ROADS 27TH STREET	205	10140+51	0.48' RT	2
		215	120111.91	0.69' RT	2
		ST. PAUL AVENUE			
		115	115P+36.45	4.91' RT	2
		E506	125P+19.77	5.37' RT	1
		135	135P+12.24	5.19' RT	2
		E511	145P+21.24	5.39' LT	2
		E520	165P+46.38	5.60' LT	2
		E523	165P+35.92	5.66' LT	2
		171	175P+25.75	5.38' LT	2
		E538	215TSP+03.90	6.72' LT	1
		E541	215TSP+14.77	3.02' RT	1
		171	254S+08.04	30' LT	1
		E553	254S+66.86	4.87' LT	2
		E559	27NN+17.67	0.14' LT	2
		SUBTOTAL			
		TOTAL			

Addendum No. 03
ID 1060-27-74
Revised Sheet 395
September 4, 2025

PROJECT NO: 1060-27-74

HWY: IH 94

COUNTY: MILWAUKEE

MISCELLANEOUS QUANTITIES

SHEET

395

E

FILE NAME: C:\USERS\BMD006\DC_ACC\DCS\WISDOT\106027\PROJECT FILES\CORE EAST SEGMENT\10602774\DSGN\QTY\MQ\FINAL\PS\MQ-D9A.DWG

PLOT DATE: 9/2/2025 11:39 AM

PLOT NAME:

BRANDON DOORSE EIT

PLOT SCALE: 1"=1'

WISDOT/CAD05 SHEET 42

STORM SEWER STRUCTURES										STORM SEWER PIPES											
ROADWAY	STRUCTURE NO.	COVER STAGE	STATION	OFFSET (FT)	LOCATION	RIM ELEV	STRUCTURE TYPE	INLET/MANHOLE COVERS	STRUCTURE DEPTH (FT)	STRUCTURE COMMENTS	PIPE STAGE	FROM STR	TO STR	INLET ELEV	DISCH ELEV	SLOPE	PLAN LENGTH (FT)	PIPE CLASS	PIPE SIZE (INCH)	PIPE COMMENTS	
TWC	731	1B	1064+27.72	55.00	RT	614.94*	MANHOLES 6-FT DIAMETER	NO COVER	8.40	VV-B COVER INSTALLED IN EAST LEG CONTRACT (1060-27-72)	--	--	--	--	--	--	--	--	--	--	
	KS	800	2	216S+40.83	RT	593.04	MANHOLES 4-FT DIAMETER	58A	9.61		--	--	--	--	--	--	--	--	--	--	--
	TLC	801	1A	191LC+63.99	73.23	LT	622.76	MANHOLES 4-FT DIAMETER	J		7.06	1A	801	802	615.69	614.86	1.00%	84	III	12	--
	TLC	802	2	201LC+77.09	64.18	RT	619.84	MANHOLES 4-FT DIAMETER	J		5.08	1A	802	TL1114	614.86	614.03	1.10%	75	III	12	--
	TLC	1117	1A	211LC+74.50	44.35	RT	617.38	MANHOLES 4-FT DIAMETER	J		4.53	1A	1117	TL1105	617.38	612.84	1.00%	47	III	24	--
	KS	TL164	3	29KS+16.39	37.00	RT	651.78	CATCH BASINS 4-FT DIAMETER	MS 57		8.04	3	TL164	TL165	645.74	645.66	0.50%	17	III	12	--
	KS	TL165	3	29KS+99.61	37.00	RT	651.60	CATCH BASINS 4-FT DIAMETER	MS 57		7.94	3	TL165	TL167	645.66	645.62	0.50%	7	III	12	--
	KS	TL167	3	29KS+92.78	37.00	RT	651.54	CATCH BASINS 4-FT DIAMETER	MS 57		7.91	3	TL167	TL168	645.62	645.56	0.50%	13	III	12	--
	KS	TL168	3	29KS+90.16	37.00	RT	651.49	CATCH BASINS 4-FT DIAMETER	MS 57		7.93	3	TL168	173	645.56	645.42	0.75%	19	III	12	--
	TJD	TL312	3	102TJD+46.67	24.42	LT	664.29	INLETS 24-5-FT	HM		7.38	3	TL312	TL316	666.01	666.47	1.50%	29	III	15	--
TJD	TL316	3	102TJD+17.64	23.00	LT	664.04	INLETS 4-FT DIAMETER	HM	7.37	--	3	TL316	TL320	666.47	666.18	1.50%	19	III	15	--	
	TJD	TL320	3	101TJD+86.52	23.00	LT	663.90	INLETS 4-FT DIAMETER	HM	7.72	--	3	TL320	TL332	663.87	662.72	1.37%	84	III	15	--
	TJD	TL332	3	101TJD+04.22	23.00	LT	661.51	INLETS 24-5-FT	HM	7.64	--	3	TL332	ES76	663.87	662.72	1.37%	84	III	15	--
	TEB	TL1005	1A	15TEB+01.75	45.06	RT	645.71	INLETS 4-FT DIAMETER	V	12.04	--	--	--	--	--	--	--	--	--	--	
	TEB	TL1009	1A	16TEB+17.18	45.06	RT	641.50	INLETS 24-5-FT	V	7.24	--	1A	TL1009	TL1011	634.27	631.78	2.50%	99	III	15	--
	TEB	TL1011	1A	17TEB+16.65	45.06	RT	638.81	MANHOLES 5-FT DIAMETER	VV-B	6.83	--	1A	TL1011	TL1013	631.78	630.03	2.50%	70	III	15	--
	TEB	TL1013	1A	17TEB+86.45	46.37	RT	636.86	MANHOLES 4-FT DIAMETER	J	6.85	--	1A	TL1013	TL1015	630.03	627.91	3.00%	71	III	15	--
	TEB	TL1014	1A	19TEB+61.69	21.37	RT	633.94	INLETS 4-FT DIAMETER	V	8.23	--	1A	TL1014	TL1015	625.71	625.57	0.50%	28	III	12	--
	TEB	TL1015	1A	19TEB+57.01	49.47	RT	634.65	INLETS 24-5-FT	V	9.33	--	1A	TL1015	TL1016	625.32	623.87	2.50%	58	III	15	--
	TEB	TL1016	1A	19TEB+13.99	51.04	RT	632.74	INLETS 24-5-FT	V	9.64	--	1A	TL1016	TL1017	623.10	620.08	2.50%	121	III	15	--
TEB	TL1017	1A	17TEB+86.14	57.06	RT	636.73	INLETS 4-FT DIAMETER	V	6.39	--	1A	TL1017	TL1013	630.34	630.28	0.50%	11	III	12	--	
	TEB	TL1019	1A	18TEB+74.77	2.94	RT	632.92	INLETS 4-FT DIAMETER	V	7.10	--	1A	TL1019	TL1014	625.83	625.71	0.50%	23	III	12	--
	TEB	TL1021	1A	18TEB+74.77	5.06	LT	632.71	INLETS 24-5-FT	V	6.84	--	1A	TL1021	TL1019	625.87	625.83	0.50%	8	III	12	--
	TEB	TL1022	1A	19TEB+20.23	2.94	RT	631.08	INLETS 4-FT DIAMETER	V	6.72	--	1A	TL1022	TL1023	624.36	624.25	0.50%	23	III	12	--
	TEB	TL1023	1A	19TEB+44.71	25.09	RT	632.15	INLETS 24-5-FT	V	7.90	--	1A	TL1023	TL1016	624.25	624.12	0.50%	26	III	12	--
	TEB	TL1025	1A	19TEB+20.05	5.06	LT	630.77	INLETS 24-5-FT	V	6.37	--	1A	TL1025	TL1022	624.40	624.35	0.50%	8	III	12	--
	TEB	TL1029	1B	20TEB+37.61	8.77	LT	626.55	INLETS 24-5-FT	V	6.27	--	1B	TL1029	TL1030	620.66	620.62	0.50%	12	III	12	--
	TEB	TL1030	1A	20TEB+37.41	2.94	RT	627.47	INLETS 4-FT DIAMETER	V	7.07	--	1A	TL1030	TL1032	620.62	620.44	0.50%	36	III	12	--
	TEB	TL1032	1A	20TEB+31.99	38.07	RT	629.46	INLETS 24-5-FT	V	9.26	--	1A	TL1032	TL1101	620.44	620.33	0.50%	23	III	12	--
	TEB	TL1034	1A	21TEB+80.48	2.94	RT	625.32	INLETS 4-FT DIAMETER	V	7.27	PIER 3 FLOOR DRAIN DOWNSPOUT CONNECTION	1B	TL1034	TL1107	618.06	618.00	0.50%	11	III	12	--
TEB	TL1037	1B	21TEB+78.10	8.00	LT	624.85	INLETS 4-FT DIAMETER	V	6.85	--	2	TL1037	TL1031	618.00	617.88	0.50%	24	III	12	--	
	TEB	TL1038	1B	22TEB+33.13	6.22	LT	624.28	INLETS 24-5-FT	V	7.00	--	1B	TL1038	TL1039	617.28	616.66	1.00%	62	III	12	--
	TEB	TL1039	1A	22TEB+94.50	2.94	RT	623.22	INLETS 4-FT DIAMETER	V	6.68	--	1A	TL1039	TL1032	616.66	615.59	2.00%	54	III	12	--
	TEB	TL1040	1A	21TEB+48.76	42.84	RT	617.39	CATCH BASINS 5-FT DIAMETER	V	8.60	--	1A	TL1040	TL1056	608.80	608.62	1.00%	18	III	30	--
	TEB	TL1044	1A	22TEB+42.44	63.00	RT	622.12	INLETS MEDIAN 2 GRATE	20-MS	10.58	--	1A	TL1044	TL1048	611.54	610.61	1.00%	93	III	24	--
	TEB	TL1046	1A	23TEB+32.50	62.50	RT	618.52	INLETS MEDIAN 2 GRATE	20-MS	7.91	--	1A	TL1048	TL1052	610.51	609.44	1.00%	117	III	24	--
	TEB	TL1052	1A	24TEB+50.00	57.11	RT	614.09	MANHOLES 6-FT DIAMETER	C	5.15	--	1A	TL1052	TL1040	608.84	608.80	1.00%	14	III	30	--
	TEB	TL1056	1B	24TEB+60.29	24.98	RT	617.89	MANHOLES 7-FT DIAMETER	J	9.27	--	1B	TL1056	TL1060	608.82	608.38	0.30%	81	IV	30	--
	TEB	TL1060	1B	25TEB+28.21	34.93	RT	615.38	MANHOLES 5-FT DIAMETER	J	7.00	--	1B	TL1060	TL2008	608.38	608.34	0.30%	11	IV	30	--
	TLC	TL1101	1A	20TLC+32.44	6.06	RT	629.69	INLETS 24-5-FT	V	9.61	--	1A	TL1101	TL1105	620.08	615.85	2.50%	169	III	15	--
TLC	TL1105	1A	22TLC+01.38	6.06	RT	627.61	INLETS 4-FT DIAMETER	V	15.23	--	1A	TL1105	TL1107	612.38	612.15	1.00%	23	III	24	--	
	TLC	TL1107	1A	22TLC+01.38	17.08	LT	627.36	INLETS 4-FT DIAMETER	V	15.22	--	1A	TL1107	TL2003	612.15	612.06	1.00%	8	III	24	--
	TLC	TL1109	1A	23TLC+57.40	17.08	LT	628.51	INLETS 24-5-FT	V	11.61	--	1A	TL1109	TL1048	616.90	614.81	4.00%	52	III	15	--
	TLC	TL1112	1A	24TLC+30.21	19.57	LT	630.00	INLETS 24-5-FT	V	7.10	--	1A	TL1112	TL2004	622.00	622.02	2.50%	35	III	15	--
	TLC	TL1113	1A	24TLC+96.90	27.31	LT	631.27	INLETS 24-5-FT	V	6.69	--	1A	TL1113	TL2005	624.59	623.78	3.00%	27	III	15	--
	TLC	TL1114	1A	21TLC+50.00	44.91	RT	617.23	MANHOLES 4-FT DIAMETER	C	4.30	--	1A	TL1114	1117	613.03	612.85	1.00%	25	III	24	--
	TML	TL2001	2	212TML+62.27	2.46	RT	652.81	MANHOLES 4-FT DIAMETER	J	9.15	--	2	TL2001	TL3000	643.66	643.36	4.81%	6	III	18	--
	TEB	TL2002	1A	23TEB+31.86	41.49	RT	621.96	MANHOLES 4-FT DIAMETER	J	6.38	--	1A	TL2002	TL1048	615.59	615.06	2.50%	21	III	12	--
	TEB	TL2003	1A	21TEB+92.55	64.18	RT	626.35	MANHOLES 4-FT DIAMETER	J	14.28	--	1A	TL2003	TL1044	612.06	611.54	1.00%	52	III	24	--
	TLC	TL2004	1A	23TLC+92.83	17.24	LT	629.29	MANHOLES 4-FT DIAMETER	J	7.26	--	1A	TL2004	TL1109	622.02	621.52	1.50%	33	III	15	--
TLC	TL2005	1A	24TLC+97.87	23.35	LT	630.60	MANHOLES 4-FT DIAMETER	J	6.82	--	1A	TL2005	TL1112	623.78	623.18	2.50%	35	III	15	--	
	TML	TL2008	1B	22TML+31.70	41.41	RT	615.16	MANHOLES 6-FT DIAMETER	J	7.82	--	1B	TL2008	ES93	607.34	607.32	0.20%	13	IV	42	--
	TML	TL3000	2	212TML+66.63	3.30	RT	652.72	MANHOLES 5-FT DIAMETER	VV-B	9.37	--	2	TL3000	TL3004	643.36	637.99	4.81%	111	III	18	--
	TML	TL3001	2	212TML+68.19	24.43	RT	653.55	INLETS 24-5-FT	J	7.14	--	2	TL3001	TL3000	648.40	648.30	0.50%	21	III	12	--
	TML	TL3003	2	213TML+80.19	4.27	LT	649.86	MANHOLES 4-FT DIAMETER	J	9.78	--	2	TL3003	TL3004	640.10	639.94	2.00%	8	III	12	--
	TML	TL3003.1	2	213TML+80.45	36.81	LT	649.16	INLETS 24-5-FT	V	5.36	--	--	--	--	--	--	--	--	--	--	
	TML	TL3004	2	213TML+80.12	3.41	RT	649.98	MANHOLES 5-FT DIAMETER	VV-B	12.48	--	2	TL3004	TL3008	637.49	632.64	3.25%	149	III	24	--
	*TOP OF SLAB ELEVATION										--	--	--	--	--	--	--	--	--	--	--
										CONSTRUCT UNDER CLOSURE	LESS THAN 2" COVER FROM TEB SUBGRADE LESS THAN 2" COVER FROM TEB SUBGRADE										

EMERGENCY PAVEMENT REPAIR ITEMS

STAGE	LOCATION	204.0120 REMOVING ASPHALTIC SURFACE MILLING	SY	305.0120 BASE AGGREGATE DENSE 1 1/4-INCH	TON	390.0100 REMOVING PAVEMENT FOR BASE PATCHING	CY	416.0610 DRILLED TIE BARS	EACH	416.0620 DRILLED DOWEL BARS	EACH	416.1715 CONCRETE PAVEMENT REPAIRS	SHES	416.1725 CONCRETE REPLACEMENT SHES	SY	450.1100.S ASPHALTIC MIXTURE FOR EXTREME CONDITIONS	TON	455.0605 TACK COAT	GAL	460.6224 HMA PAVEMENT 4 MT 58.28 S	TON	465.0125 ASPHALTIC SURFACE TEMPORARY	TON	495.1000.S COLD PATCH	TON	690.0105 SAWING ASPHALT LF	690.0250 SAWING CONCRETE LF	SPV.0060.0556 EMERGENCY RESPONSE TO PAVEMENT REPAIR	EACH	SPV.0195.0443 HMA LONGITUDINAL JOINT REPAIR	TON	SPV.0195.0444 HMA TRANSVERSE JOINT REPAIR	TON
ALL	PROJECT 1060-27-74	1000		2,500	500			370	230	360	10	1,070	50	1,070	500	200	100	3,200	550	10	50	25											
	TOTALS	1,000		2,500	500			370	230	360	10	1,070	50	1,070	500	200	100	3,200	550	10	50	25											

* ADDITIONAL QUANTITIES SHOWN ELSEWHERE

TEMPORARY SHORING ITEMS

511.1200.0010										511.2300.0001										511.2300.0002									
TEMPORARY SHORING (R-40-10)										TEMPORARY SHORING (IH 94 EB)										TEMPORARY SHORING LEFT IN PLACE (IH 94 WB)									
STAGE	LOCATION	STATION	TO	STATION	OFFSET	SF				STAGE	LOCATION	STATION	TO	STATION	OFFSET	SF				STAGE	LOCATION	STATION	TO	STATION	OFFSET	SF			
1	IH 94 EB	15TEB+48	-	20TEB+12	RT	4,000	-	-	-	1	IH 94 EB	17TEB+90	-	22TEB+64	RT	-	-	-	-	1	RAMP LC	24TEB+30	-	25TEB+11	RT	-	-	-	-
1	IH 94 EB	17TEB+90	-	22TEB+64	RT	-	-	-	-	1	RAMP LC	24TEB+30	-	25TEB+11	RT	1,000	-	-	-	1	IH 94 WB	218TWB+75	-	222TWB+57	RT	-	-	-	-
4	IH 94 WB	218TWB+75	-	222TWB+57	RT	-	-	-	-	4	IH 94 WB	218TWB+75	-	222TWB+57	RT	-	-	-	-	900									
TOTALS						4,000	1,000	3,300	900							4,000	1,000	3,300	900										

Addendum No. 03
ID 1060-27-74
Revised Sheet 404
September 4, 2025

Addendum No. 03
ID 1060-27-74
Revised Sheet 829
September 4, 2025

GENERAL NOTES

DRAWINGS SHALL NOT BE SCALED.
BEVEL EXPOSED EDGES OF CONCRETE 1/4". UNLESS NOTED OTHERWISE.
REFER TO SPECIAL PROVISIONS FOR INTERIM COMPLETION DATES.
COORDINATES ON THIS PLAN ARE REFERENCED TO THE WISCONSIN COUNTY COORDINATE SYSTEM (WCS). MILWAUKEE COUNTY ZONE, NAD 83 (2007). ALL STATIONS AND ELEVATIONS ARE IN FEET. ELEVATIONS ARE REFERENCED TO THE NORTH AMERICAN VERTICAL DATUM NAVD 88 (2007).
ALL DIMENSIONS ARE ALONG THE FRONT FACE OF WALL, UNLESS SHOWN OTHERWISE.
ALL BAR STEEL REINFORCEMENT IS TO BE EPOXY COATED. BAR STEEL REINFORCEMENT SHALL HAVE 2" CLEAR COVER, UNLESS SHOWN OTHERWISE.
THE EXISTING GROUND LINE SHALL BE THE UPPER LIMITS OF EXCAVATION FOR STRUCTURES RETAINING WALLS (R-40-761).
THE CONTRACTOR SHALL COORDINATE THE REMOVAL OF EXISTING STRUCTURE R-40-513.5 AND CONSTRUCTION OF THE EXISTING BRIDGE R-40-513.5 IS A FOUR-SPAN STEEL TRUSS GIRDER BRIDGE. R-40-761. THE EXISTING BRIDGE R-40-513.5 IS A FOUR-SPAN STEEL TRUSS GIRDER BRIDGE. R-40-761.
THE UTILITY INFORMATION SHOWN ON THESE DRAWINGS CONCERNING TYPE AND LOCATION OF UNDERGROUND UTILITIES IS NOT GUARANTEED TO BE ACCURATE OR ALL INCLUSIVE. THE CONTRACTOR IS RESPONSIBLE FOR MAKING THEIR OWN DETERMINATIONS AS TO THE TYPE AND LOCATION OF UNDERGROUND UTILITIES AS MAY BE NECESSARY TO AVOID DAMAGE. UTILITIES LABELED AS PROPOSED MAY BE INSTALLED BY OTHERS PRIOR TO THIS CONTRACT.
NAME PLATE SHALL BE CONSIDERED INCIDENTAL TO ITEM 504.0500 "CONCRETE MASONRY RETAINING WALLS". FABRICATE IN ACCORDANCE TO SDD 12 A 3-30.
HAZMAT CONTAMINATED SOIL EXISTS FROM APPROXIMATELY STA 2008+70 TO STA 2013+25. HAULING AND DISPOSAL OF THE TOP 25" (OR TO DEPTH DIRECTED BY THE MISSOURI DEPARTMENT OF ENVIRONMENT AND NATURAL RESOURCES) OF EXCAVATED SOIL SHALL BE THE RESPONSIBILITY OF THE CONTRACTOR. "TIEBACK ANCHORS" EXCAVATION FOR STRUCTURES RETAINING WALLS (R-40-761) ARE INCLUDED IN "WALL CONCRETE PANEL MECHANICALLY STABILIZED EARTH LIFT" (R-40-761) ARE INCLUDED IN "EXCAVATION, HAULING AND REUSE OF LOW-LEVEL PETROLEUM CONTAMINATED SOIL". HAULING AND DISPOSAL OF THE REMAINING CONTAMINATED EARTHWORK/SPILLS ARE INCLUDED IN "EXCAVATION, HAULING, AND DISPOSAL OF PETROLEUM CONTAMINATED SOIL". MANAGEMENT OF EAST OF 27TH ST. SEE ROADWAY PLANS FOR THE LIMITS OF HAZMAT CONTAMINATED SOIL.

ESTIMATE OF QUANTITIES

ITEM NO.	BID ITEMS	UNIT	UNIT 1	UNIT 2	TOTAL
206.3001.0761	EXCAVATION FOR STRUCTURES RETAINING WALLS (R-40-761)	LS	---	---	1
501.1000.5	ICE HOT WEATHER CONCRETING	LB	27,490	---	27,490
502.0110.5.0761	CONCRETE MASONRY SOLDIER PILE FOOTINGS	CY	2,050	---	2,050
504.0500	CONCRETE MASONRY RETAINING WALLS	CY	1,615	---	1,615
505.0600	BAR STEEL REINFORCEMENT HS COATED STRUCTURES	LB	175,250	---	175,250
506.1035	WELDED STUD SHEAR CONNECTORS 7/8 X 10 INCH	EACH	7,952	---	7,952
511.2000.0761	TEMPORARY SHORING R-40-761	SF	500	68	568
511.2000.0761	TEMPORARY SHORING LEFT IN PLACE R-40-761	SF	---	223	223
513.2001.0761	RAILING PIPE R-40-761	LF	1,230	385	1,615
516.0100	DAMP PROOFING	SY	---	642	642
516.0500	RUBBERIZED MEMBRANE WATERPROOFING	SY	---	5	5
517.0601	PAINTING EPOXY SYSTEM	EACH	1	---	1
612.0206	PIPE UNDERDRAIN UNPERFORATED 6-INCH	LF	380	75	455
612.0806	APRON ENDWALLS FOR UNDERDRAIN REINFORCED CONCRETE 6-INCH	EACH	3	1	4
SPV.0060.4400	TIEBACK ANCHORS	EACH	466	---	466
SPV.0060.4410	TIEBACK ANCHORS PERFORMANCE TESTS	EACH	25	---	25
SPV.0060.4800	RETAINING WALL INSTRUMENTATION R-40-761	EACH	1	---	1
SPV.0075.4010	OBSTRUCTION FOUNDATION DRILLING	HRS	120	---	120
SPV.0085.4000	STRUCTURAL STEEL HS SOLDIER PILES DELIVERED	LB	1,616.194	---	1,616.194
SPV.0085.4010	STRUCTURAL STEEL HS SOLDIER PILES INSTALLED	LB	1,460.116	---	1,460.116
SPV.0090.0260	PIPE UNDERDRAIN 6-INCH SPECIAL	LF	1,230	385	1,615
SPV.0090.4200	FOUNDATION DRILLING	LF	127,350	42,350	170,000
SPV.0110.4000	TIMBER LAGGING	MBM	119	---	119
SPV.0165.4000	GEOCOMPOSITE DRAIN BOARD	SF	30,952	30,535	61,487
SPV.0165.4761	WALL CONCRETE PANEL MECHANICALLY STABILIZED EARTH LIFT (R-40-761)	SF	---	4,726	4,726
---	NON-BID ITEMS	---	---	---	---
---	NON-BITUMINOUS JOINT FILLER	SIZE	---	1"	1"
---	CORK FILLER	SIZE	---	1"	1"
---	NAME PLATE	EACH	---	1	1
---	EXPANDED POLYSTYRENE	SIZE	---	1"	1"
---	PREFORMED JOINT FILLER	SIZE	---	3/4"	3/4"

ALL ITEMS ARE CATEGORY 3000

FILE NAME: C:\USERS\JTEGEM\1060\CCDC\WISDOT\10602703\PROJECT FILES\CORE EAST SEGMENT\10602703\STRUCTURE\3_SCRATCH\TEGEM\1060_05_GN.DWG
LAYOUT NAME: SHEET 829

SOLDIER PILE WALL NOTES

RETAINING WALLS (R-40-761). SEE SPECIAL PROVISIONS FOR DESCRIPTION OF FLOWABLE BACKFILL AND CLSM.
TIMBER LAGGING DESIGN ASSUMES NO R-40-767 CONSTRUCTION AND NO LIVE LOAD PRESENT ON THE EXISTING BRIDGE R-40-513.5. IF THESE ASSUMPTIONS ARE NOT MET, THE CONTRACTOR WILL BE RESPONSIBLE FOR THE DESIGN AND THE COST OF MODIFICATIONS TO THE "TIMBER LAGGING".
SURFACE PREP AND PAINT SOLDIER PILES FROM TOP OF PILE TO 1'-0" BELOW TOP OF FOOTING WITH WELDED STUD SHEAR CONNECTORS ARE NOT REQUIRED TO BE PAINTED. PAINTING OF PILES IS MEASURED AND PAID FOR AS BID ITEM NUMBER 517.0600, PAINTING EPOXY SYSTEM R-40-761.
THE REINFORCEMENT REQUIRED TO INSTALL THE SOLDIER PILES, FOOTINGS, TIEBACK ANCHORS, AND BAR STEEL REINFORCEMENT FOR STRUCTURES RETAINING WALLS (R-40-761) ARE INCLUDED IN "CONCRETE MASONRY SOLDIER PILE FOOTINGS" AND "CONCRETE MASONRY SOLDIER PILE FOOTINGS" QUANTITY ESTIMATES ARE BASED ON THE ASSUMPTION BEDROCK IS ENCOUNTERED AT ESTIMATED ELEVATIONS AND ARE TO BE PAID BASED UPON QUANTITY INSTALLED.
"STRUCTURAL STEEL HS SOLDIER PILES DELIVERED" ESTIMATED QUANTITY IS BASED ON MAXIMUM PILE LENGTH REQUIRED IF BEDROCK IS NOT ENCOUNTERED.
"STRUCTURAL STEEL HS SOLDIER PILES INSTALLED", "FOUNDATION DRILLING" AND "CONCRETE MASONRY SOLDIER PILE FOOTINGS" QUANTITY ESTIMATES ARE BASED ON THE ASSUMPTION BEDROCK IS ENCOUNTERED AT ESTIMATED ELEVATIONS AND ARE TO BE PAID BASED UPON QUANTITY INSTALLED.

MSE WALL NOTES

MSE RETAINING WALL SOIL REINFORCEMENT MAY BE PLACED UP TO A MAXIMUM OF 15' FROM PERPENDICULAR IF NECESSARY TO AVOID INTERFERENCE WITH ITEMS BEHIND THE WALL. ANGLES GREATER THAN 15' REQUIRE APPROVAL FROM THE BUREAU OF STRUCTURES DESIGN SECTION.
THE CONTRACTOR SHALL PROVIDE COMPLETE DESIGN, PLANS, DETAILS, SPECIFICATIONS, AND SHOP DRAWINGS FOR THE MSE RETAINING WALL IN ACCORDANCE WITH THE SPECIAL PROVISIONS. THE MSE RETAINING WALL MANUFACTURER SHALL PROVIDE TECHNICAL ASSISTANCE TO THE CONTRACTOR DURING CONSTRUCTION. THE COST OF FURNISHING THESE ITEMS IS INCLUDED IN "WALL CONCRETE PANEL MECHANICALLY STABILIZED EARTH LIFT (R-40-761)".
THE COST OF FURNISHING AND PLACING THE UNREINFORCED CONCRETE LEVELING PAD UNDER THE MSE PRECAST WALL PANELS IS INCLUDED IN THE BID ITEM "WALL CONCRETE PANEL MECHANICALLY STABILIZED EARTH LIFT (R-40-761)".

WALL EXTERNAL STABILITY EVALUATION

WALL DIMENSIONS ¹	STA 2012+50	STA 2016+00
R/L RETAINING WALL STATION	37.0	34.0
DESIGN WALL HEIGHT (FT) ²	35.0	32.0
DESIGN EXPOSED WALL HEIGHT (FT)	35.0	32.0
REINFORCEMENT RATIO	0.60H ²	0.60H ²
WALL STATION	2012+30 TO 2015+00	2015+00 TO 2016+15
BORING USED	REFER TO GEOTECHNICAL REPORT	
CAPACITY TO DEMAND RATIO (CDR)	1.00	1.41
SLIDING ³	>3.00	>3.00
ECCENTRICITY ²	1.08	1.18
BEARING ³	1.00	NP ⁴
GLOBAL STABILITY ³	1.00	NP ⁴

NOTES:
¹ THIS WALL IS PART OF A SUPERIMPOSED (TIERED) MSE WALL AND SHOULD BE DESIGNED AS ONE TIERED WALL.
² THE DESIGN WALL HEIGHT (H) FOR THE LOWER WALL EQUALS THE UPPER + LOWER WALL HEIGHT.
³ THE CDR VALUES SHOWN ARE THE MINIMUM BETWEEN THE UNDRAINED AND DRAINED ANALYSIS.
⁴ NP: NOT PERFORMED. GLOBAL STABILITY WAS NOT PERFORMED AT THIS SECTION. PREVIOUS SECTION IS MORE CRITICAL.

SOIL PARAMETERS

SOIL DESCRIPTION	UNIT WEIGHT (PCF)	UNDRAINED FRICTION ANGLE (DEGREES)	UNDRAINED COHESION (PSF)	DRAINED FRICTION ANGLE (DEGREES)	DRAINED COHESION (PSF)
NEW GRANULAR FILL	125	---	---	32	---
EXISTING BACKFILL	125	---	1250 - 2000	30	50
SOFT-MEDIUM STIFF CLAY	125	---	750 - 1000	28	0
PEAT AND ORGANIC	90	---	500	20	0
LOOSE TO MEDIUM DENSE SAND	120	---	---	29	0
GLACIAL TILL	135	---	3500	35	0


09/03/2025

DESIGN DATA

THE VOLUME OF EARTHWORK REQUIRED TO INSTALL THE UNREINFORCED CONCRETE LEVELING PAD, BACKFILL, ANCHORS AND REINFORCING STRIPS IS INCLUDED IN THE BID ITEM "EXCAVATION FOR STRUCTURES RETAINING WALLS (R-40-761)". SEE WALL EXCAVATION LIMITS DIAGRAM ON SHEET 6 FOR DETAILS.
THE PLAN QUANTITY FOR THE ITEM "WALL CONCRETE PANEL MECHANICALLY STABILIZED EARTH LIFT (R-40-761)" IS BASED ON A WALL HEIGHT MEASURED FROM THE TOP OF THE LEVELING PAD TO THE EXISTING FINISHED GRADE AND 2' BELOW FINISHED GRADE AND 2' BELOW EXISTING GRADE. WALL AREAS CONSTRUCTED OUTSIDE THESE LIMITS WILL NOT BE MEASURED FOR PAYMENT.
PLANS, ELEVATIONS, AND DETAILS SHOWN ON THESE DRAWINGS ARE INTENDED TO INDICATE MSE WALL LOCATIONS, LENGTHS, HEIGHTS, AND DETAILS COMMON TO THE MSE WALL SYSTEM. THE CONTRACTOR SHALL VERIFY THAT THE WALL SYSTEM SELECTED WILL CONFORM TO THE REQUIRED ALIGNMENTS AND DETAILS.
CONCRETE MASONRY RETAINING WALLS:
CONCRETE MASONRY RETAINING WALLS: $f_c = 4,000$ PSI
PRECAST CONCRETE SOLDIER PILE FOOTINGS: $f_c = 4,000$ PSI
CONCRETE MASONRY SOLDIER PILE FOOTINGS: $f_c = 3,500$ PSI
BAR STEEL REINFORCEMENT: $f_y = 60,000$ PSI
HIGH STRENGTH STRUCTURAL STEEL: $f_y = 50,000$ PSI
ASTM A709, GRADE 50
TIMBER LAGGING: $f_b = 1,200$ PSI
 $E = 1,700,000$ PSI
REFERENCE: ASHTO LRFD SPECIFICATION TABLE 8.4.11.4-1.
DESIGN UNIT 2 MSE WALL FOR A HORIZONTAL BACKSLOPE BEHIND THE WALL AND A LIVE LOAD SURCHARGE OF 240 PSF.
MATERIAL VALUES BASED ON DOUGLAS FIR-LARCH NO. 1, 3-2" WIDE.
REFERENCE: ASHTO LRFD SPECIFICATION TABLE 8.4.11.4-1.

HORIZONTAL CURVE DATA

THE QUANTITIES OF CONCRETE MASONRY AND BAR STEEL REINFORCEMENT FOR THE UNIT 2 CAST-IN-PLACE COPING ARE INCIDENTAL TO BID ITEM "WALL CONCRETE PANEL MECHANICALLY STABILIZED EARTH LIFT".
THE COST OF FURNISHING AND PLACING LIGHTWEIGHT FOAMED CONCRETE FILL (LCF) WITHIN THE REINFORCED SOIL ZONE IS TO BE INCLUDED IN THE BID ITEM "WALL CONCRETE PANEL MECHANICALLY STABILIZED EARTH LIFT". SEE ROADWAY PLANS FOR THE QUANTITY OF LIGHTWEIGHT FOAMED CONCRETE FILL OUTSIDE OF THE REINFORCED SOIL ZONE.
LIGHTWEIGHT FOAMED CONCRETE FILL (LCF) SHALL BE PLACED IN LIFTS NOT EXCEEDING 4 FEET IN DEPTH. EACH SUCCESSIVE LIFT WILL BE PLACED AFTER A MINIMUM OF 24 HOURS.
THE CONTRACTOR SHALL PROVIDE SUITABLE SUPPORTS FOR THE MSE REINFORCING STRIPS AND FACING PANELS DURING PLACEMENT OF LIGHTWEIGHT FOAMED CONCRETE FILL.

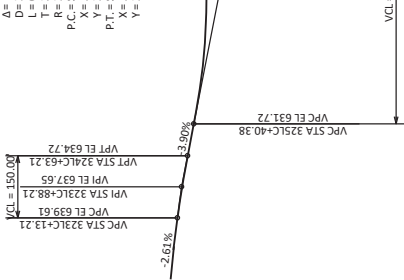

PROFILE GRADE LINE - LC

HI-94 EB EXIT RAMP TO 26TH ST AND ST PAUL AVE
AT CONCLUSION OF FUTURE CONTRACT 1060-27-72


NO.	DATE	REVISION	BY
01/03/25	08/19/25	DELETE MSE WALL NOTE	PRK
02/03/25	08/19/25	TIMBER LAGGING QUANTITY	PRK




STATE OF WISCONSIN DEPARTMENT OF TRANSPORTATION	STRUCTURE R-40-761
FORWARD BY	MTZ LKD
PRK	

GENERAL NOTES, QUANTITIES & PROFILE GRADE LINES	829
SHEET 5 OF 38	

SCALE = N/A

Addendum No. 03
ID 1060-27-74
Revised Sheet 852
September 4, 2025

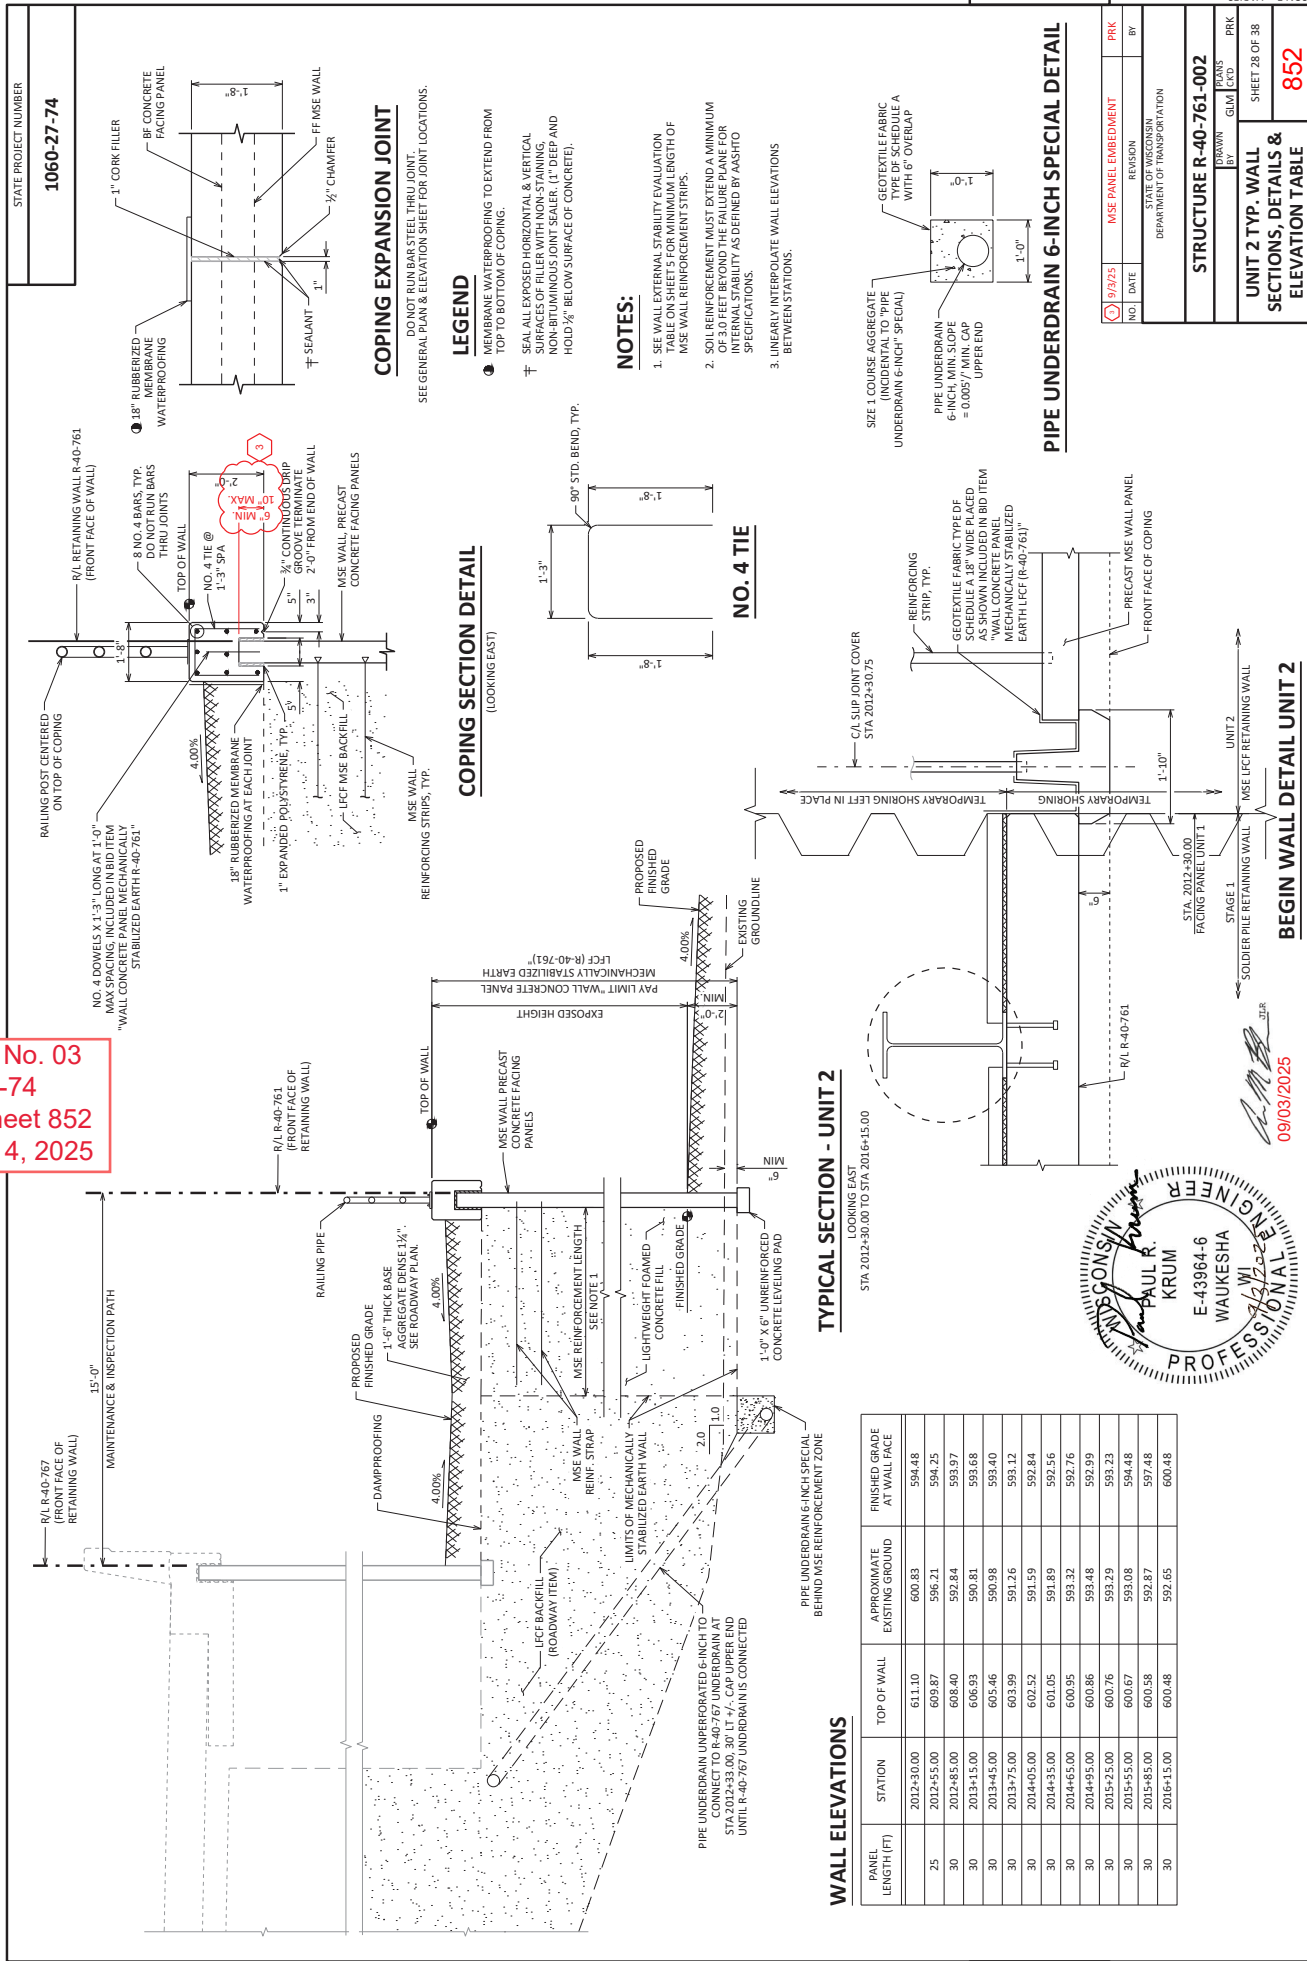

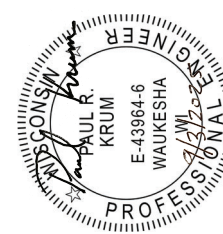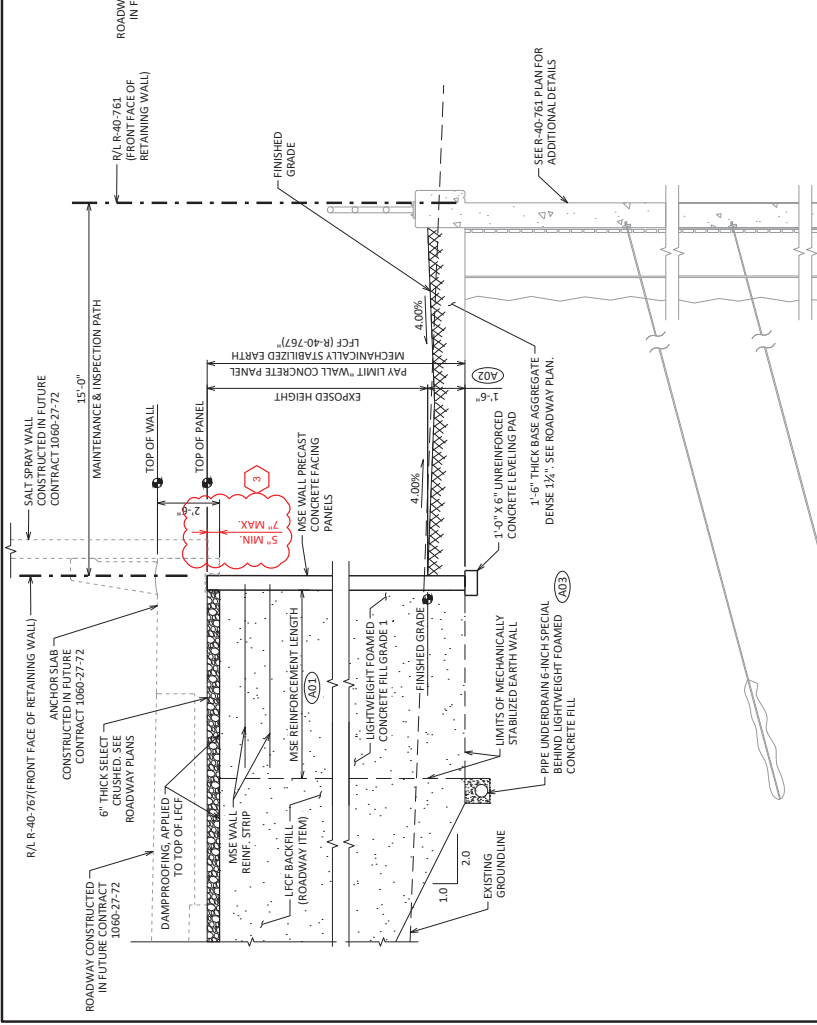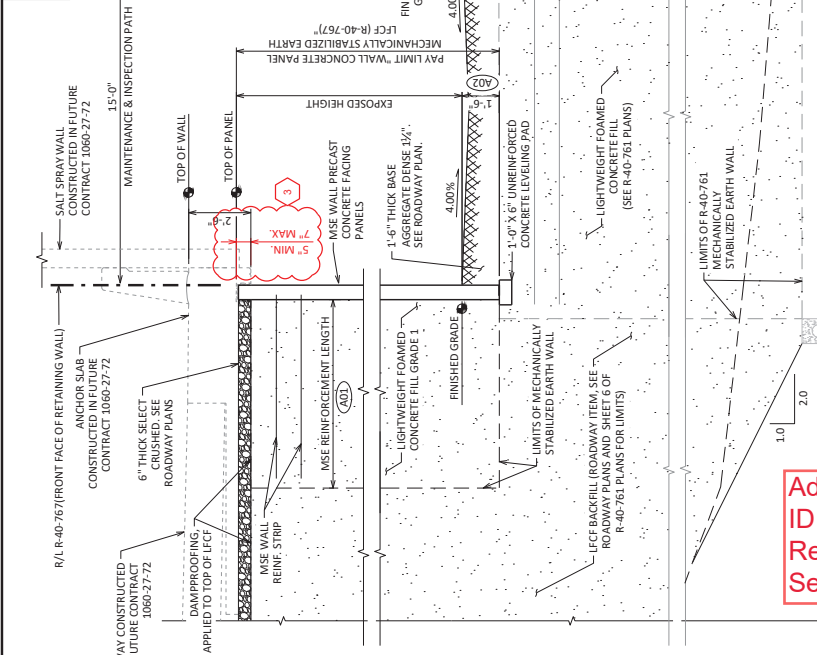


TYPICAL SECTION
(LOOKING EAST)
(STA 1003+74.3 TO STA 1007+65.00)

09/03/2025

LEGEND

- (A01) SEE WALL EXTERNAL STABILITY EVALUATION ON SHEET 3 FOR MINIMUM LENGTH OF MSE WALL REINFORCING STRIPS. SOIL REINFORCEMENT MUST EXTEND A MINIMUM OF 3.0 FEET BEYOND THE FAILURE PLANE FOR INTERNAL STABILITY AS DEFINED BY AASHTO SPECIFICATIONS.
- (A02) MINIMUM DIMENSION FROM FUTURE FINISHED GRADE AT FRONT FACE OF WALL TO TOP OF LEVELING PAD AS SHOWN. CONSTRUCTION OF THE LEVELING PAD WITH THE WALL PANEL FABRICATION, PAY LIMITS BASED ON MINIMUM DIMENSION.
- (A03) PIPE UNDERDRAIN TO BE CAPED AT WEST END OF R-40-761. SLOPE UNDERDRAIN TO THE EAST. AT THE END OF R-40-761 UNIT 1, DROP R-40-761 UNDERDRAIN TO CONNECT TO R-40-761 UNIT 2 UNDERDRAIN AND DISCHARGE AT R-40-761 STA 2015+50, 45° RT. NO R-40-761 UNDERDRAIN NECESSARY ABOVE R-40-761 UNIT 2.

 TYPICAL SECTION
(LOOKING EAST)
(STA 1000+00.00 TO STA 1003+74.3)



PK	DATE	REVISION	BY
PK	09/03/25	MSE PANEL EMBEDMENT	PK
STATE OF WISCONSIN DEPARTMENT OF TRANSPORTATION			
STRUCTURE R-40-767 (STAGE 1)			
DESIGNED BY	DRWN	GLM	EKM
CHECKED BY	CHK	GLM	EKM
SHEET 4 OF 11			866
TYPICAL WALL SECTIONS			(1 OF 2)

WALL ELEVATIONS

STATION	PANEL LENGTH (FT)	TOP OF WALL *	TOP OF PANEL	EXISTING GROUND	FINISHED GRADE AT R-40-767 WALL FACE
1000+00.00	---	642.44	640.44	616.42	618.02
1000+30.00	30	641.62	639.62	616.10	616.53
1000+55.00	25	640.90	638.90	615.66	616.28
1000+80.00	25	640.17	638.17	615.34	616.03
1001+10.00	30	639.37	637.37	615.11	615.73
1001+40.00	30	638.56	636.56	615.11	615.43
1001+70.00	30	637.67	635.67	615.13	615.13
1002+00.00	30	636.70	634.70	615.12	614.83
1002+30.00	30	635.65	633.65	615.20	614.53
1002+60.00	30	634.53	632.53	615.24	614.23
1002+90.00	30	633.36	631.36	615.26	613.93
1003+20.00	30	632.19	630.19	612.53	613.05
1003+50.00	30	631.03	629.03	609.12	612.07
1003+80.00	30	629.86	627.86	601.03	610.57
1004+10.00	30	628.89	626.89	596.96	609.07
1004+40.00	30	628.03	626.03	593.43	607.57
1004+70.00	30	627.30	625.30	590.99	606.07
1005+00.00	30	626.75	624.75	591.29	604.58
1005+30.00	30	626.23	624.23	591.60	603.08
1005+60.00	30	625.83	623.83	591.83	601.58
1005+90.00	30	625.54	623.54	591.79	600.55
1006+20.00	30	625.37	623.37	593.10	600.46
1006+50.00	30	625.30	623.30	593.50	600.36
1006+80.00	30	625.45	623.45	593.44	600.26
1007+10.00	30	625.96	623.96	593.18	600.17
1007+40.00	30	626.44	624.44	592.92	600.07
1007+70.00	30	626.93	624.93	592.68	599.98
1008+00.00	30	627.51	625.51	592.17	599.88
1008+30.00	30	628.10	626.10	592.91	599.78
1008+60.00	30	628.69	626.69	593.60	599.69
1008+85.00	25	629.37	627.37	594.26	599.61

LEGEND

* AT CONCLUSION OF FUTURE CONTRACT 1060-27-72


LINEARLY INTERPOLATE WALL ELEVATIONS BETWEEN STATIONS.

3 TOP OF PANEL ELEVATION IS BASED ON 6" EMBEDMENT WITH 1"± TOLERANCE. THIS IS TO ACCOMMODATE TO THE EXTENTS POSSIBLE THE OPTION OF FABRICATING PANELS THAT ARE LEVEL ON TOP.

401 SEE WALL EXTERNAL STABILITY EVALUATION ON SHEET 3 FOR MINIMUM LENGTH OF MSE WALL REINFORCING STRIPS. SOIL REINFORCEMENT MUST EXTEND A MINIMUM OF 3.0 FEET BEYOND THE FAILURE PLANE FOR INTERNAL STABILITY AS DEFINED BY AASHTO SPECIFICATIONS.

402 MINIMUM DIMENSION FROM FUTURE FINISHED GRADE AT FRONT FACE OF WALL TO TOP OF LEVELING PAD AS SHOWN. COORDINATE CONSTRUCTION OF THE LEVELING PAD WITH THE WALL PANEL FABRICATOR. PAY LIMITS BASED ON MINIMUM DIMENSION.


403 PIPE UNDERDRAIN TO BE CAPPED AT THE EAST END OF R-40-767 STAGE 1. SLOPE UNDERDRAIN TO WEST. AT STA 1008+85.00 CONNECT R-40-767 UNDERDRAIN TO R-40-761 STAGE 1 UNDERDRAIN AND DAYLIGHT TO SUITABLE DRAINAGE AT R-40-761 STA 20+55-502.

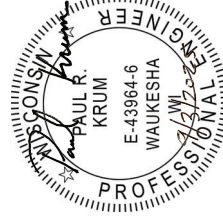

09/03/2025
JLR


PIPE UNDERDRAIN 6-INCH SPECIAL DETAIL

SIZE 1 COARSE AGGREGATE (INCIDENTAL TO "PIPE UNDERDRAIN 6-INCH SPECIAL")

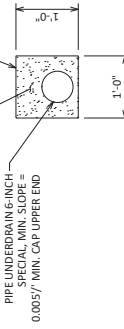


SLIP JOINT DETAIL


(STA 1003+80.00)

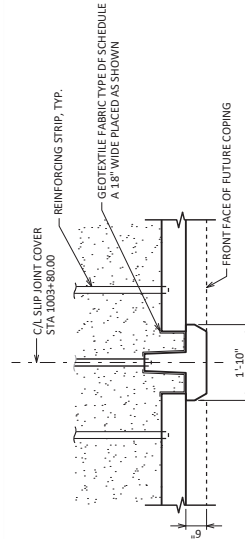

TYPICAL SECTION

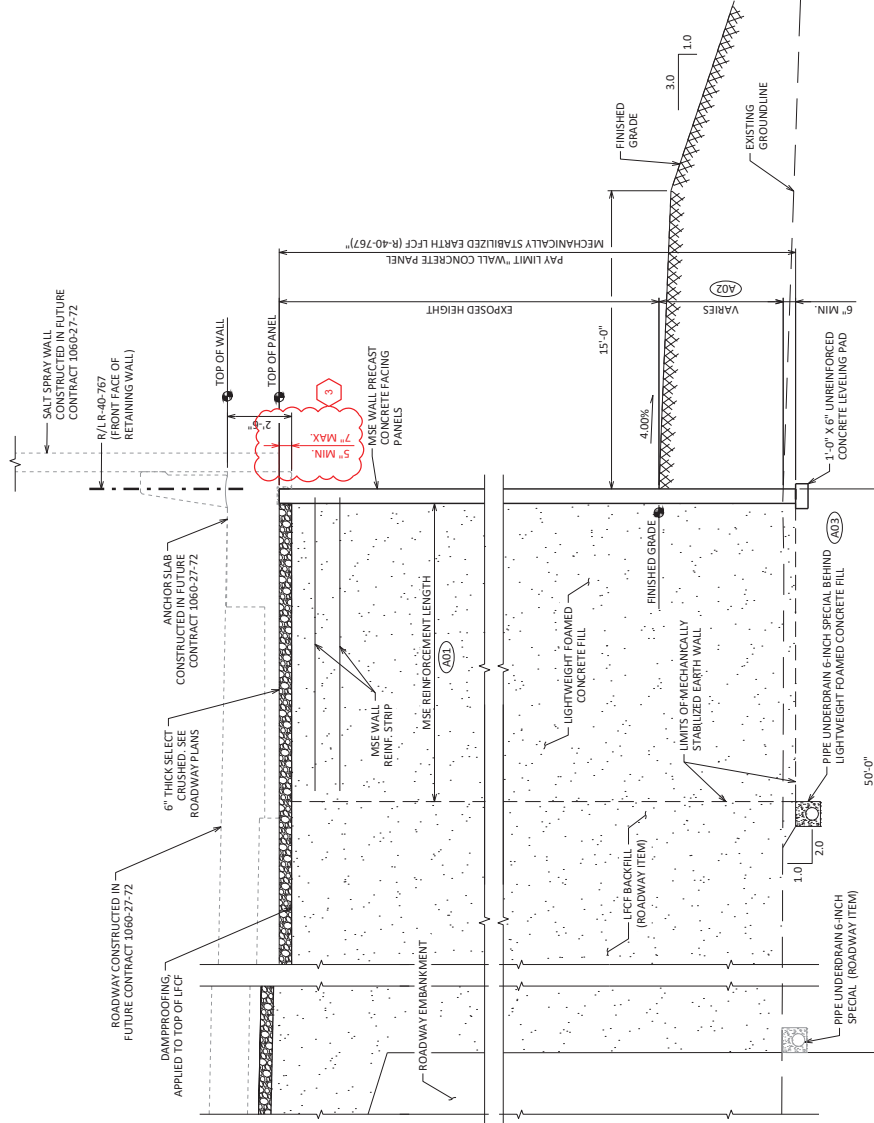(LOOKING EAST)
(STA 1007+45.00 TO STA 1008+85.00)


Addendum No. 03
ID 1060-27-74
Revised Sheet 867
September 4, 2025

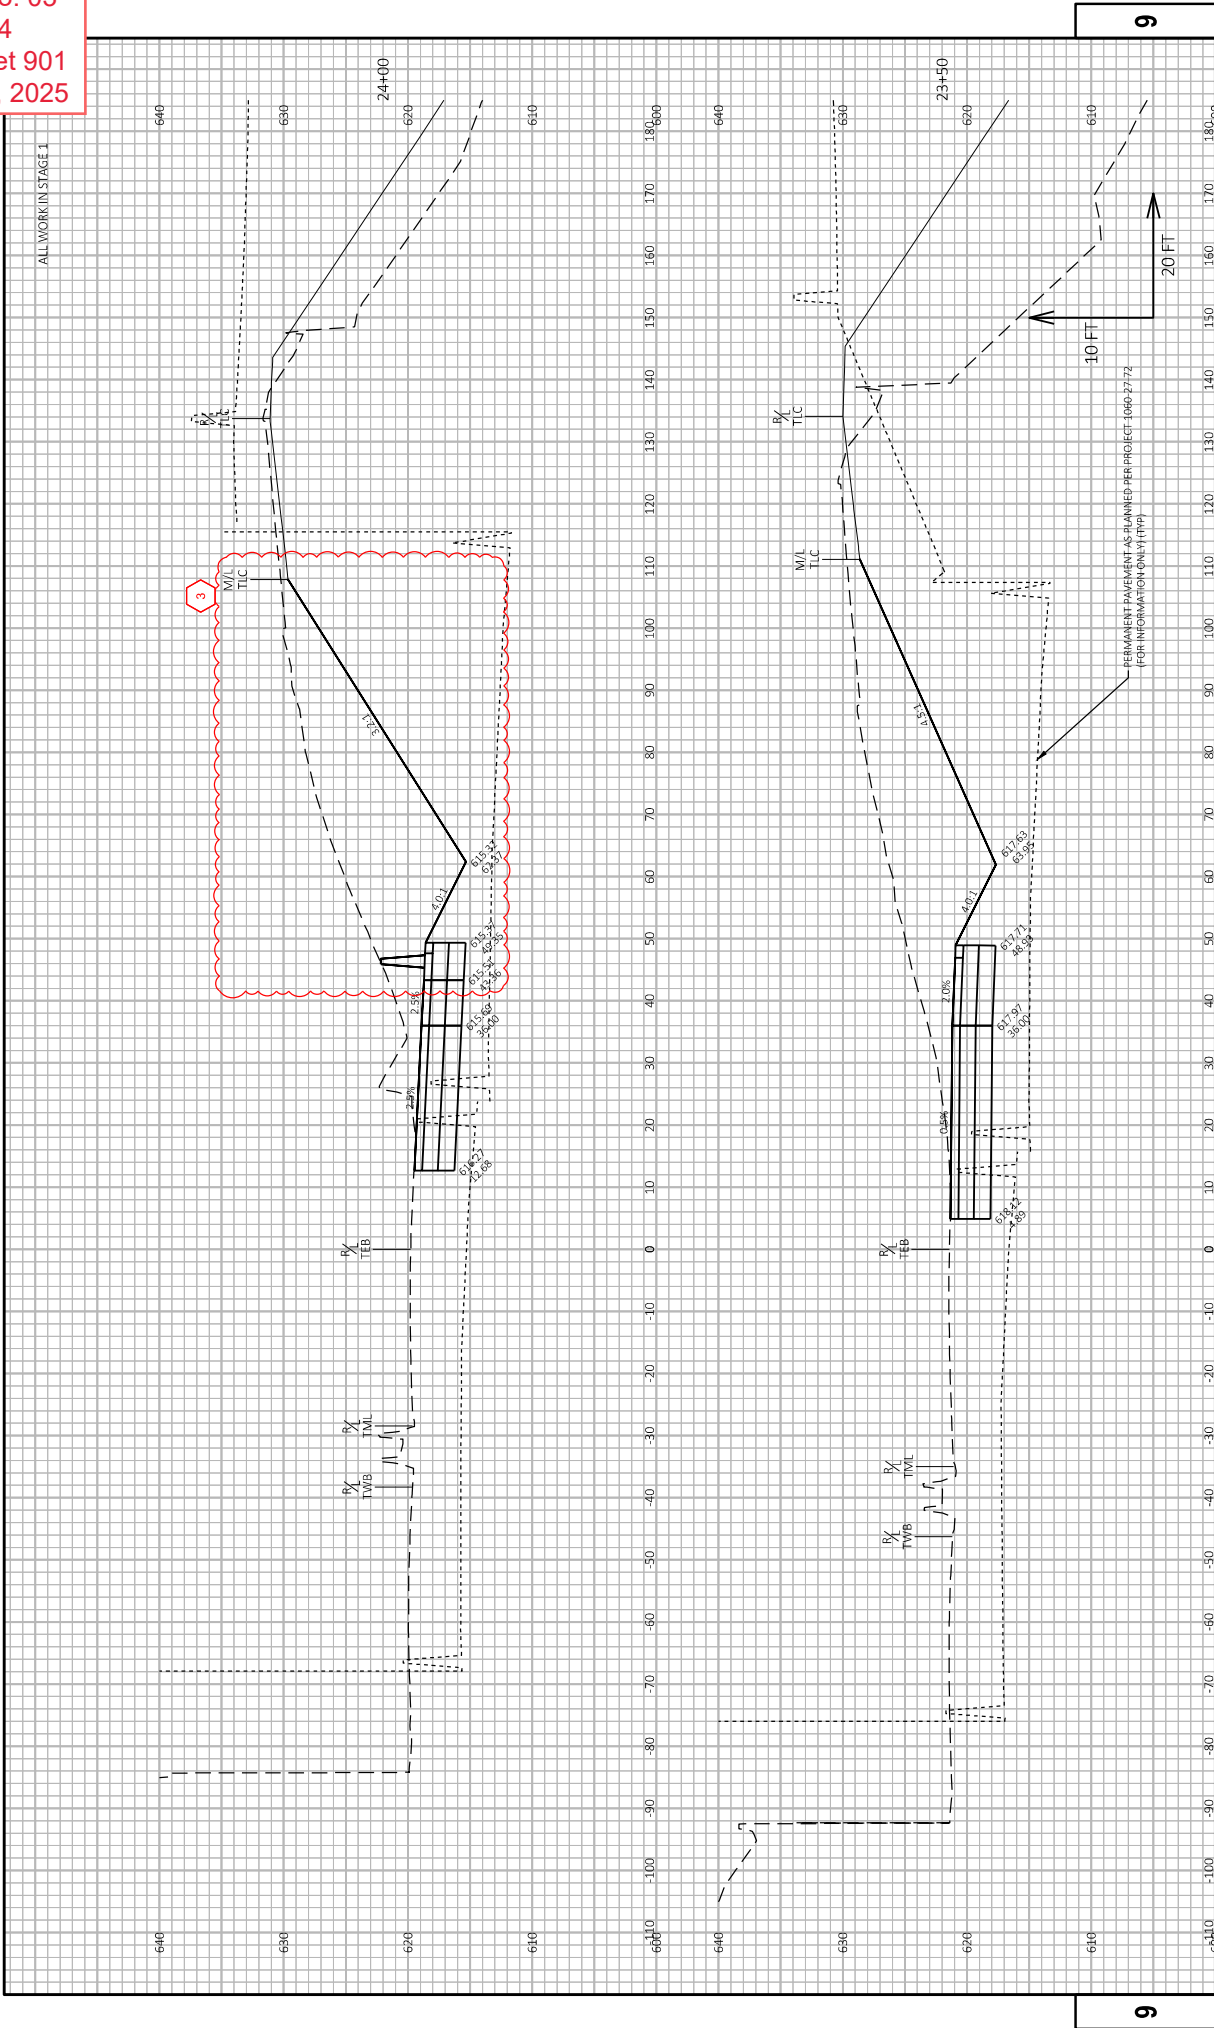

PROJECT NO: 1060-27-74	COUNTY: MILWAUKEE	CROSS SECTIONS: IH 94 EB - TEB	SHEET 901	E
FILE NAME: C:\USERS\FESCHER\DO\ACCD\DOCS\WISDOT\10602774\PROJECT FILES\CORE EAST SEGMENT\10602774\SHEETS\901-01\1060-27-74-EB-TEB.DWG	DATE: 9/2/2025 4:57 PM	BY: PESCHER, N/A	SCALE: 1 IN. = 20 FT. VERT. / 1 IN. = 10 FT. HORIZ.	WISDOT/CADD 9/2/25 4:57 PM



Addendum No. 03
ID 1060-27-74
Revised Sheet 903
September 4, 2025

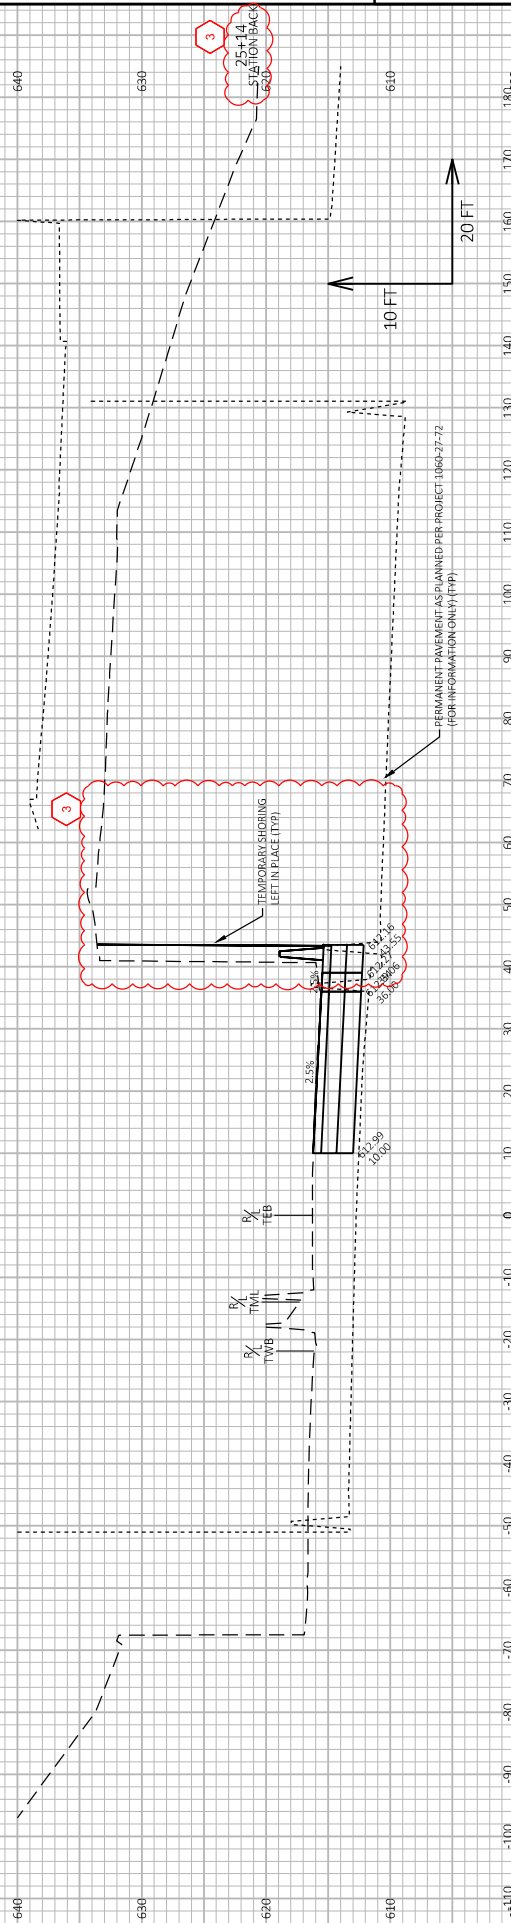

PROJECT NO:	1060-27-74	HWY:	IH 94	COUNTY:	MILWAUKEE	CROSS SECTIONS:	IH 94 EB - TEB	SHEET	903	E
FILE NAME : C:\USER\PESCHKE\DOCC\DCS\WISDOT\I0602703\PROJECT FILES\CORE EAST SEGMENT\I0602703\SHEETS\903.XS.I0602703EA-90001-GS-EW-TEB.DWG								PLOT DATE: 9/2/2025 4:57 PM		
LAYOUT NAME : 21								PLOT BY : PESCHEL, NTL		PLOT SCALE : 1 IN=20 FT HORIZ / 1 IN=10 FT VERT
WISDOT/CADS SHEET 49										



Proposal Schedule of Items

Page 2 of 31

Proposal ID: 20250909007 Project(s): 1060-27-74

Federal ID(s): WISC 2025597

SECTION: 0001

Contract Items

Alt Set ID:

Alt Mbr ID:

Proposal Line Number	Item ID Description	Approximate Quantity and Units	Unit Price	Bid Amount
0030	204.0150 Removing Curb & Gutter	130.000 LF	_____.	_____.
0032	204.0155 Removing Concrete Sidewalk	1,560.000 SY	_____.	_____.
0034	204.0157 Removing Concrete Barrier	2,170.000 LF	_____.	_____.
0036	204.0165 Removing Guardrail	1,400.000 LF	_____.	_____.
0038	204.0170 Removing Fence	2,840.000 LF	_____.	_____.
0040	204.0195 Removing Concrete Bases	26.000 EACH	_____.	_____.
0042	204.0210 Removing Manholes	12.000 EACH	_____.	_____.
0044	204.0220 Removing Inlets	38.000 EACH	_____.	_____.
0046	204.0245 Removing Storm Sewer (size) 0001. 12-Inch	1,321.000 LF	_____.	_____.
0048	204.0245 Removing Storm Sewer (size) 0002. 15-Inch	1.000 LF	_____.	_____.
0050	204.0245 Removing Storm Sewer (size) 0003. 18-Inch	118.000 LF	_____.	_____.
0052	204.0245 Removing Storm Sewer (size) 0004. 21-Inch	351.000 LF	_____.	_____.
0054	204.0245 Removing Storm Sewer (size) 0005. 24-Inch	428.000 LF	_____.	_____.
0056	204.0245 Removing Storm Sewer (size) 0006. 27-Inch	276.000 LF	_____.	_____.



Proposal Schedule of Items

Page 3 of 31

Proposal ID: 20250909007 Project(s): 1060-27-74

Federal ID(s): WISC 2025597

SECTION: 0001

Contract Items

Alt Set ID:

Alt Mbr ID:

Proposal Line Number	Item ID Description	Approximate Quantity and Units	Unit Price	Bid Amount
0058	204.0245 Removing Storm Sewer (size) 0007. 30-Inch	20.000 LF	_____.	_____.
0060	204.0250 Abandoning Manholes	4.000 EACH	_____.	_____.
0062	204.0265 Abandoning Wells	3.000 EACH	_____.	_____.
0064	204.0291.S Abandoning Sewer	12.000 CY	_____.	_____.
0066	204.9001.S Removing Advance Flasher Assemblies Type 1	1.000 EACH	_____.	_____.
0068	204.9060.S Removing (item description) 0001. Steps Railing	2.000 EACH	_____.	_____.
0070	204.9060.S Removing (item description) 1002. Lighting Units	35.000 EACH	_____.	_____.
0072	204.9060.S Removing (item description) 3101. Traffic Signals W St Paul Ave & N 27th St	1.000 EACH	_____.	_____.
0074	204.9165.S Removing (item description) 0002. Landscape Rock	1,360.000 SF	_____.	_____.
0076	205.0100 Excavation Common	70,498.000 CY	_____.	_____.
0078	205.0501.S Excavation, Hauling, and Disposal of Petroleum Contaminated Soil	1,415.000 TON	_____.	_____.
0080	206.1001 Excavation for Structures Bridges (structure) 1083. B-40-1083	1.000 EACH	_____.	_____.
0082	206.3001 Excavation for Structures Retaining Walls (structure) 0761. R-40-761	1.000 EACH	_____.	_____.
0084	209.0200.S Backfill Controlled Low Strength	40.000 CY	_____.	_____.



Proposal Schedule of Items

Page 7 of 31

Proposal ID: 20250909007 Project(s): 1060-27-74

Federal ID(s): WISC 2025597

SECTION: 0001

Contract Items

Alt Set ID:

Alt Mbr ID:

Proposal Line Number	Item ID Description	Approximate Quantity and Units	Unit Price	Bid Amount
0174	506.6000 Bearing Assemblies Expansion (structure) 1083.B-40-1083	21.000 EACH	_____.	_____.
0176	509.1500 Concrete Surface Repair	250.000 SF	_____.	_____.
0178	511.1200 Temporary Shoring (structure) 0010. R-40-10	4,000.000 SF	_____.	_____.
0180	511.1200 Temporary Shoring (structure) 0761. R-40-761	568.000 SF	_____.	_____.
0182	511.2200 Temporary Shoring Left in Place (structure) 0057. B-40-57	1,000.000 SF	_____.	_____.
0184	511.2200 Temporary Shoring Left in Place (structure) 0761. R-40-761	223.000 SF	_____.	_____.
0186	511.2300 Temporary Shoring Left in Place (location) 0001. IH 94 EB	3,300.000 SF	_____.	_____.
0188	511.2300 Temporary Shoring Left in Place (location) 0002. IH 94 WB	900.000 SF	_____.	_____.
0190	512.0500 Piling Steel Sheet Permanent Delivered	225.000 SF	_____.	_____.
0192	512.0600 Piling Steel Sheet Permanent Driven	225.000 SF	_____.	_____.
0194	513.2001 Railing Pipe 0761. R-40-761	1,615.000 LF	_____.	_____.
0196	513.4091 Railing Tubular Screening	826.000 LF	_____.	_____.
0198	514.0450 Floor Drains Type WF	5.000 EACH	_____.	_____.
0200	514.2608 Downspout 8-Inch	270.000 LF	_____.	_____.