

January 30, 2018

Division of Transportation Systems Development

Bureau of Project Development 4802 Sheboygan Avenue, Rm 601 P O Box 7916 Madison, WI 53707-7916

Telephone: (608) 266-1631 Facsimile (FAX): (608) 266-8459

NOTICE TO ALL CONTRACTORS:

Proposal #02:3803-00-65, WISC 2018 0813803-00-66C Beaver Dam, North Spring StreetC Beaver Dam,W Maple Avenue to Mackie StreetW Maple AvenueLoc StrLoc StrDodge CountyDodge County

3803-00-66 C Beaver Dam, North Spring Street W Maple Avenue to Mackie Street Loc Str Dodge County

Letting of February 13, 2018

This is Addendum No. 01, which provides for the following:

Special Provisions:

	Revised Special Provisions
Article Description	
39	U-Channel Sign Post 12-FT, SPV.0060.22; 13-FT, SPV.0060.23; 14-FT, SPV.0060.24.

Added Special Provisions Article Description	
Article No.	Description
50	Pedestrian Flasher System, Item SPV.0105.06.

	Deleted Special Provisions
Article No.	Description
32	Install City Furnished Street Signs, SPV.0060.05.
47	Rectangular Rapid Flashing Beacon (RRFB) With Pedestrian Activation, Item SPV.0105.04.

Schedule of Items:

Revised Bid Item QuantitiesBid ItemItem DescriptionUnitOld QuantityRevised QuantityProposal Total637.2210Signs Type II Reflective HSF73.24376.24637.2230Signs Type II Reflective FSF37.79-14.9122.88652.0225Conduit Ridge Nonmetallic Schedule 40 2-InchLF2334-242310					
Bid Item	Item Description	Unit			•
637.2210	Signs Type II Reflective H	SF	73.24	3	76.24
637.2230	Signs Type II Reflective F	SF	37.79	-14.91	22.88
652.0225	Conduit Ridge Nonmetallic Schedule 40 2-Inch	LF	2334	-24	2310
654.0101	Concrete Base Type I	EACH	2	-1	1
655.0610	Electrical Wire Lighting 12 AWG	LF	4732	-72	4660
655.0620	Electrical Wire Lighting 8 AWG	LF	7834	4	7838
SPV.0060.24	U-Channel Sign Post 14-FT	EACH	11	-4	7

Bid ItemItem DescriptionUnitQuantityQuantityTotalSPV.0060.28U-Channel Sign Post 16-FTEACH022					
Pid Itom	Itom Description		Old	Revised	Proposal
Did item	Item Description	Unit	Quantity	Quantity	Total
SPV.0060.28	U-Channel Sign Post 16-FT	EACH	0	2	2
SPV.0105.06	Pedestrian Flasher System	LS	0	1	1

Bid Item	Item Description	Unit	- · - ·		•
SPV.0060.05	Install City Furnished Street Signs	EACH	15	-	0
SPV.0060.22	U-Channel Sign Post 12-FT	EACH	13	-13	0
SPV.0105.04	Rectangular Rapid Flashing Beacon (RRFB) with Pedestrian Activation	LS	1	-1	0

Plan Sheets:

	Revised Plan Sheets	
Plan Sheet	Plan Sheet Title (brief description of changes to sheet)	
20	Permanent Signing and Pavement Markings (school zone signs were added and moved to appropriate locations, street name signs/no parking sign removed)	
21	 20 appropriate locations, street name signs/no parking sign removed) Permanent Signing and Pavement Markings (school zone signs were added and moved to appropriate locations, signs associated with the Pedestrian Flasher System were also clarified with no additional posts and paid for as part of the SPV, street name signs/no parking signs removed) 22 Street Lighting Plan (reference to the RRFB was removed the plan sheet and the additional RRFB pole and conduit was removed) 23 Street Lighting Plan (reference to the RRFB was removed the plan sheet) Miscellaneous Quantities (added SPV.0060.28, U-Channel Sign Post 16-FT, added school zone signs, updated Yellow Diagonal Arrow sign code, updated signs and sign post quantities including removing U-Channel Sign Post 12-FT, SPV.0060.22) Miscellaneous Quantities (removed RRFB reference, updated light unit location and 	
22	Street Lighting Plan (reference to the RRFB was removed the plan sheet and the additional RRFB pole and conduit was removed)	
23		
37	zone signs, updated Yellow Diagonal Arrow sign code, updated signs and sign post	
38	Sheet Plan Sheet Title (brief description of changes to sheet) 20 Permanent Signing and Pavement Markings (school zone signs were added and moved to appropriate locations, street name signs/no parking sign removed) 21 Permanent Signing and Pavement Markings (school zone signs were added and moved to appropriate locations, signs associated with the Pedestrian Flasher System were also clarified with no additional posts and paid for as part of the SPV, street name signs/no parking signs removed) 22 Street Lighting Plan (reference to the RRFB was removed the plan sheet and the additional RRFB pole and conduit was removed) 23 Street Lighting Plan (reference to the RRFB was removed the plan sheet) 37 Miscellaneous Quantities (added SPV.0060.28, U-Channel Sign Post 16-FT, added school zone signs, updated Yellow Diagonal Arrow sign code, updated signs and sign post quantities including removing U-Channel Sign Post 12-FT, SPV.0060.22) Miscellaneous Quantities (removed RREB reference undated light unit location and the set)	
40		

	Added Plan Sheets
Plan Sheet	Plan Sheet Title (brief description of why sheet was added)
10A	Construction Detail: Pedestrian Flasher System (FHWA has terminated the use of RRFBs on all roadways effective December 21, 2017. The RRFB has been removed from the plans and replaced with the Pedestrian Flasher System assembly.)
104A	'Fines Higher' Standard Sign R2-6P Sheet Plate (added standard sign to the plan sheets)

Deleted Plan Sheets Plan Sheet Plan Sheet Title (brief description of why sheet was deleted) Construction Detail: RRFB Detail (FHWA has terminated the use of RRFBs on all roadway effective December 21, 2017. The RRFB has been removed from the plans and replaced	
Plan	Dian Shaat Title (brief description of why sheat was delated)
Sheet	An Plan Sheet Title (brief description of why sheet was deleted) Construction Detail: RRFB Detail (FHWA has terminated the use of RRFBs on all roadways
	n et Plan Sheet Title (brief description of why sheet was deleted) Construction Detail: RRFB Detail (FHWA has terminated the use of RRFBs on all roadways effective December 21, 2017. The RRFB has been removed from the plans and replaced
10	effective December 21, 2017. The RRFB has been removed from the plans and replaced
	Plan Sheet Title (brief description of why sheet was deleted)Construction Detail: RRFB Detail (FHWA has terminated the use of RRFBs on all roadway effective December 21, 2017. The RRFB has been removed from the plans and replaced

The responsibility for notifying potential subcontractors and suppliers of these changes remains with the prime contractor.

Sincerely,

Mike Coleman

Proposal Development Specialist Proposal Management Section

ADDENDUM NO. 01 3803-00-65/66 January 30, 2018

Special Provisions

32. DELETED.

39. U-Channel Sign Post 13-FT, SPV.0060.23; 14-FT, SPV.0060.24; 16-FT, SPV.0060.28.

Replace the entire article language with the following.

A Description

This special provision describes furnishing and installing U-Channel Sign Posts, and powder coating sign posts black in accordance to section 634 of the standard specifications, as shown in the plans or as directed by the engineer, and as hereinafter provided.

B Materials

Furnish sign posts consisting of hot rolled flanged channel section from high strength steel conforming to ASTM A-499, grade 60 modified to 70,000 psi minimum yield. Posts shall be straightened to have smooth uniform finish, free from defects affecting their strength, durability, or appearance. All edges shall be free from burrs. The permissible tolerance for straightness shall be ¼" in a 5' span. Posts shall be punched with continuous 3/8" diameter holes on 1" centers for the entire length of the posts, beginning 1" from one end of the post. Length of each post shall be as shown in the plans as required to meet the proper sign mounting heights and a 3' minimum embedment.

The sign posts shall be polyester powder coated black (RAL color 9017) according to the manufacturer's recommendations.

C Construction

C1 Delivery, Storage and Handling

Deliver material to the site in an undamaged condition. Upon receipt at the job site, thoroughly inspect all materials to ensure that no damage occurred during shipping or handling and conditions of materials is in conformance with these specifications. If the coating is damaged, repair or replace equipment to the approval of the engineer at no additional cost. Carefully store the material off the ground to ensure proper ventilation and drainage. Exercise care so as not to damage the coated surface during installation.

C2 Touch-up and Repair

For minor damage caused by shipping, handling or installation to coated surfaces, touch-up the surface in conformance with the manufacturer's recommendations with a matching black (RAL color 9017) finish. If damage is excessive, the equipment shall be replaced at no additional cost. Provide the engineer with a copy of the manufacturer's recommended repair procedure and materials before repairing damaged coatings.

C3 Installation

Install U-Channel Sign post at locations shown in the plans and in accordance with the Manual on Uniform Traffic Control Devices.

For installations in concrete or asphalt, use box outs prior to pouring concrete to avoid cutting into the new concrete sidewalk installed in the terrace. These locations shall be field verified by contractor prior to pouring concrete. Install the posts per the manufacturer's installation instructions such that the

posts are plumb. Remove any sign posts installed that result in the posts leaning to any side out of plumb and reinstall at contractor expense.

D Measurement

The department will measure U-Channel sign posts, completed in accordance with the contract and accepted, as each individual unit acceptably completed.

E Payment

The department will pay for measured quantities at the contract unit price under the following bid items:

ITEM NUMBER SPV.0060.23	DESCRIPTION U-Channel Sign Post, 13-FT	UNIT EACH
SPV.0060.24	U-Channel Sign Post, 14-FT	EACH
SPV.0060.28	U-Channel Sign Post, 16-FT	EACH

Payment is full compensation for furnishing, producing, and installing posts, cleaning the steel; furnishing and applying the powder coating materials; loading, hauling, storing, and performing field repairs.

47. DELETED.

50. Pedestrian Flasher System, SPV.0105.06.

A Description

Furnish and install a hardwired, pushbutton activated Pedestrian Flasher System as described herein and as shown in the plans. Perform this work in accordance with Section 651, 655, 656, 657, and 658 of the Standard Specifications as it pertains to the traffic signal items, electrical work, and as hereinafter provided.

B Materials

B.1 General Requirements

The Pedestrian Flasher System shall be in conformance with all applicable MUTCD standards and guidelines.

- 1.1 Each Pedestrian Flasher shall be a complete assembly consisting of, but not limited to controller and electrical components (wiring), LED indications, signage, sign mounting and pushbuttons.
- 1.2 A Pedestrian Flasher assembly will have two (2) 12-inch LED indications (mounted back-to-back facing opposing directions) at each location. The east side of North Spring Street will be mounted on a decorative light pole at Sta 18+51.65, 26' RT. The concrete base and decorative pole at this location are paid under separate bid items. The west side of North Spring Street will be mounted on a new pole assembly at Sta 18+61.00, 24.5' LT as detailed in the project plan.
- 1.3 Individual components shall be replaceable independently of other components, equipped with approved terminal strips or wire-end molded connectors.

B.2 Functional Requirements

Per FHWA guidelines and subsequent officially issued interpretations by FHWA, the Pedestrian Flasher System shall be normally dark, shall initiate operation only upon pedestrian actuation, and shall cease operation at a predetermined time after the pedestrian actuation. The flash cycle duration should be based on the MUTCD procedures for timing of pedestrian clearance times for pedestrian signals: refer to MUTCD 2009 Section 4E.06 and any State-specified regulations.

- 2.1 Upon activation by ADA-compliant pushbutton, the yellow indications on each side of North Spring Street shall flash in an alternating "wig-wag" flashing sequence (left indication on, then right indication on).
- 2.2 When activated, all indications associated with a given crosswalk shall simultaneously commence operation of their alternating flashing within 120msec, and shall cease operation at a predetermined time after the pedestrian actuation.
- 2.3 The duration of the flash cycle shall be programmable from 1 second to 24 hours, in increments of seconds, minutes and hours.
- 2.4 The system shall include an actuation counter providing data that can be downloaded on-site to a laptop computer using DB9 or USB type cables.

B.3 Material Specification

- 3.1 LED Indication
 - a. Provide 12-inch Yellow LED signal faces and mounting hardware conforming to Section 658 of the Standard Specifications.
- 3.2 Controller
 - a. The controller shall be housed in a NEMA 4X rated aluminum enclosure, intended for indoor or outdoor use, primarily to provide a degree of protection against corrosion, windblown dust and rain, splashing water, hose-directed water, and damage from ice formation.
 - b. The LED light outputs and flash pattern shall be completely programmable, with the capability to actuate.
 - c. The flashing output shall be configurable to be a MUTCD compliant flash pattern. The flashing output shall be programmable.
 - d. The controller shall be reconfigurable if future MUTCD or State guidelines specify a different flash pattern.
 - e. The controller shall be capable of storing input count data in preset intervals, with downloadable capabilities using optional Windows-based PC software program and standard RS232 programming cable.
 - f. The controller shall be, in the unlikely event of failure, replaceable independently of other components.
- 3.3 Power Supply
 - a. The input voltage ranges from 100 to 240 volts and is between 50-60 Hz.
 - b. The maximum total output from this supply is 30 watts.
- 3.4 Pedestal Shaft
 - a. Shall meet the requirements as set forth in standard spec 657 for highway and structure construction.
 - b. Shall be a standard 4.5" OD aluminum pedestal pole. Supplied with one end threaded for easy installation into a pedestal base.
 - c. Shall be a 15' Schedule 80 pipe raw aluminum.
 - d. Note that decorative pole for 26.0' RT is provided under a separate bid item
- 3.5 Pedestal Base
 - a. Shall meet the requirements as set forth in standard spec 657 for highway and structure construction.

- b. The pedestal base shall be a cast aluminum pedestals mount on a concrete base attached by four internal anchor bolts imbedded in the base.
- c. The base shall have a large 8.5" square hand hole cover allowing access to the interior of the base.
- d. Note that decorative pole for 26.0' RT is provided under a separate bid item
- 3.5 Signs and Plaques
 - a. All signs shall conform to MUTCD standards.
 - b. All sign blanks and plaques shall be Federally specified .080 gauge, 5052 aluminum.
 - c. Unless specified otherwise, sign sheeting shall meet Section 637 of the Standard Specifications with anti-graffiti overlay.
 - d. All sign assemblies shall use provided anti-vandal fasteners and tools to mount components to sign, and sign to fixture.
 - e. School Zone signs shall be S1-1 per MUTCD (4 signs).
 - f. Crossing plaques S16-7L (2 signs) and S16-7R (2 signs) shall also accompany the school zone signs and placed accordingly.
 - g. Pedestrian pushbutton instruction signs (R10-25) shall be furnished to be mounted adjacent to or integral with each pedestrian pushbutton (2 signs).
- 3.6 Pushbutton
 - a. The Push Button shall be capable of continuous operation within a temperature range of -30° to 165°F (-34° to 74°C).
 - b. The Push Button shall be ADA compliant, and shall operate as a normally open (n/o) circuit.
 - c. The pushbuttons should comply with Section 658 of the Standard Specifications.

Provide all cable and wiring necessary for a complete operating system.

All poles, pedestal bases, poles, mounting hardware, housings, push buttons, and sign support mounting hardware, including banding straps, shall have a powder coated black finish. To prevent any marring of the finished surface, the arm assemblies shall be assembled prior to power coat application with all internal threads completely masked to prevent paint build up.

B.4 Warranty

The system shall be supported by a three-year warranty.

C Construction

Assemble Pedestrian Flasher System per the manufacturer's recommendations. Mount the controller cabinet, signage, LED beacons, and push buttons to the pole as shown on the plans and per the manufacturer's requirements.

D Measurement

The department will measure Pedestrian Flasher System, completed in accordance with the contract and accepted, as a single complete unit of work.

E Payment

The department will pay for measured quantities at the contract unit price under the following bid items:

ITEM NUMBER	DESCRIPTION	UNIT
SPV.0105.04	Pedestrian Flasher System	LS

Payment is full compensation for furnishing and installing the Pedestrian Flasher System including wire, cable, poles, pedestal bases, LED beacons and housings, signs, connections, and all necessary mounting hardware and appurtenances, and for furnishing all labor, tools, equipment, and incidentals necessary to complete the contract work.

Schedule of Items


Attached, dated January 30, 2018, are the revised Schedule of Items Pages 1 - 10.


Plan Sheets


The following $8\frac{1}{2} \times 11$ -inch sheets are attached and made part of the plans for this proposal:


Revised: 20, 21, 22, 23, 37, 38 and 40. Added: 10A, 104A. Deleted: 10


END OF ADDENDUM

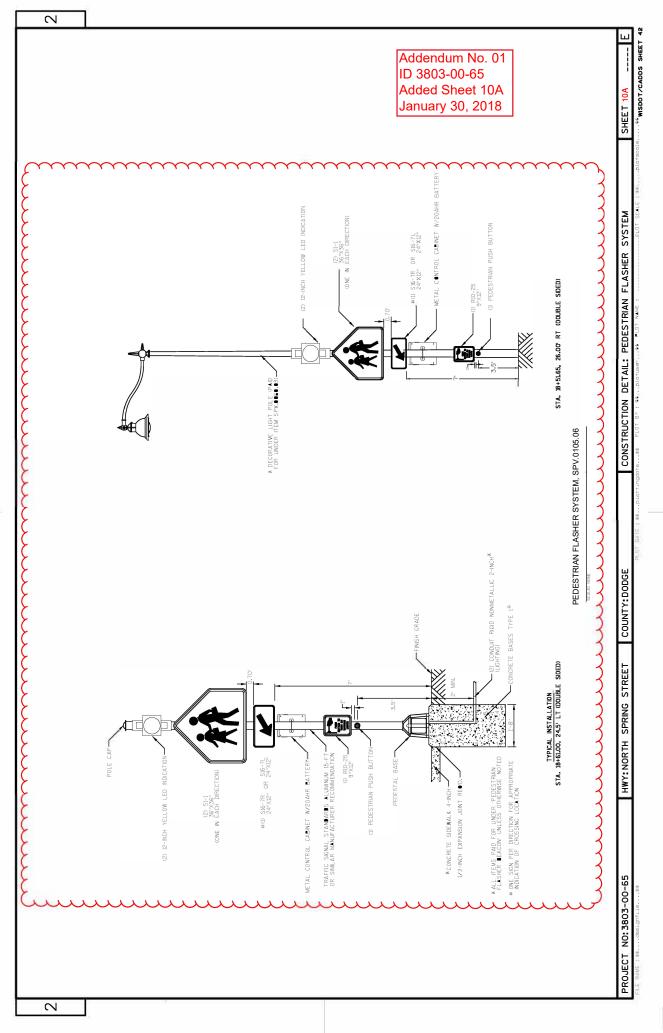

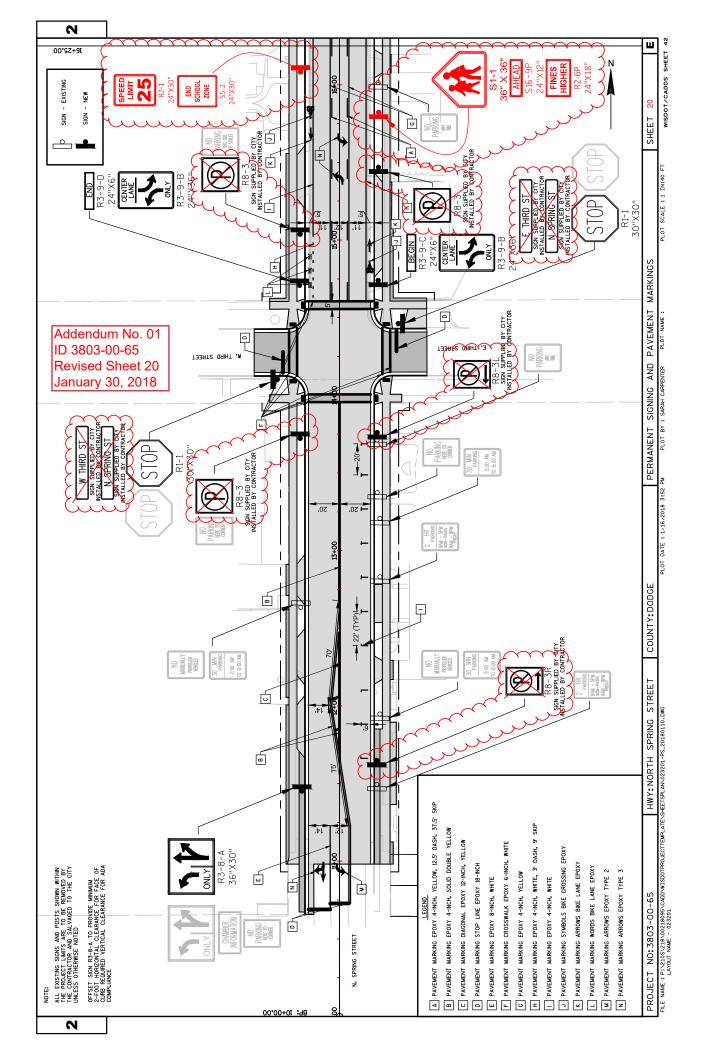

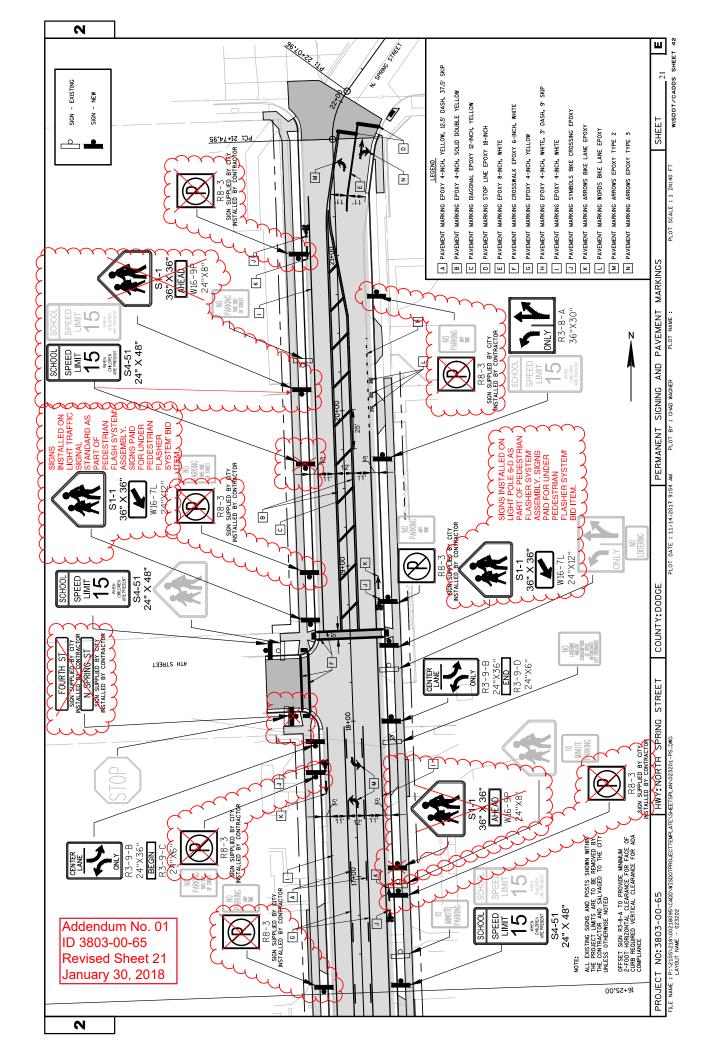


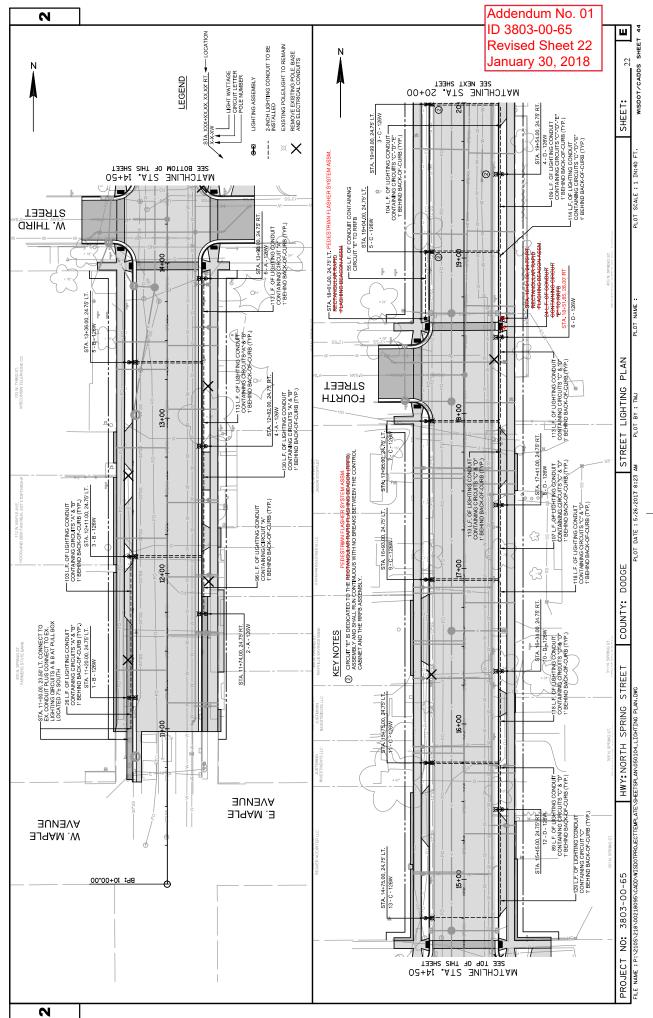

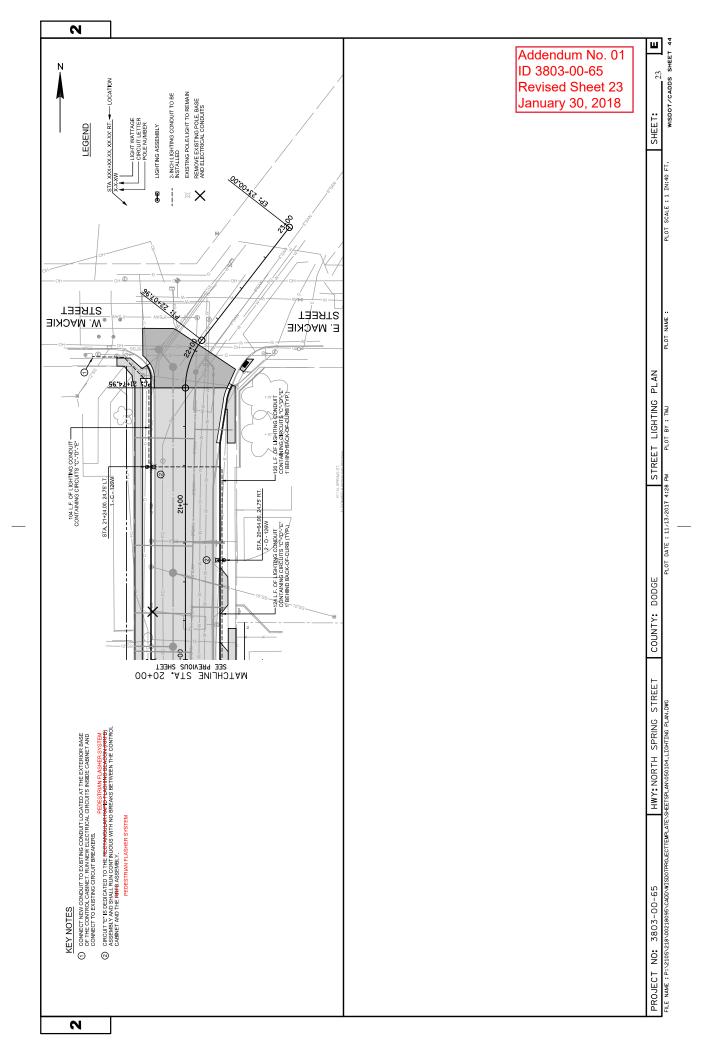


	3				Т
~~~~	~~~~~		~~~~	Revised Sheet 37	ĺ
		Ashen system LAshen system			
ST NCTES CHY SLPTHED S.CN CHY SLPTHED S.CN	105 0 011 d 16 X10	GITY 6L P LLEB C CN GITY 8L P LLEB C CN GITY 8L P LLEB C CN GITY 8L P LLEB C GN GITY 8L P LLEB C GN P AID UNDER TEM PED. F P AID UNDER TEM PED. F GITY 6L P T LEB C CN GITY 6L P T LEB C CN			
SPV CO60.28 CHANNEL SIGN PC 13 FT EACH					
SPV.3080.24 J-CHGMNEL SIGN POET 12 FT EACH	i i e i e i - i i i			Log TE BLI CE INUCA ICH TEBLI DI CE INUCA ICH TEBLI DI CE INUCA ICH TEBLI DI CE INUCA AICE DI CE INUCA AICE DI CE INUCA AICE DI CE INUCA	
SPV.CC60.25 J-CHANNEL SIGN PCST 13 FT EACH					
SPY 0330 22 J-CHANNEL SIGN POST 12 FT EACH					
(37.22.30 SIGNS TYPE II REFLECTIVE F SF '			C SISANG C SISANG C SISANG C SISANG L A PARKINS SISAS L A PARKINS SISAS L A PARKINS SISAS L A PARKINS SISAS C A PARKINS SISAS C A PARKINS SISAS	REET SIGN REET SIGN	
표 원 <mark>왕 8</mark> 8	9278880808097985	1218824年218年28日第6日	R R R R R R R R R R R R R R	FS7950 Ref FS7550 Ref FS2505 Ref	
zz	3		In the second se	NO EAF NO FAR SCHOOL SCHOOL NO FAR NO FAR NO FAR S RAF	
DE SIGN N NTERSECTION LA NO EA BRAIC SYL	Ż				
02 N018 N017C01 02 N018 N017C01 02 N018 N017C01			1 1 1 1 1 1 1 1 1 1 1 1 1 1 1 1 1 1 1		
0FFSE 26 25			CATEGORY		
	<u> </u>		the second secon		

**സ** 

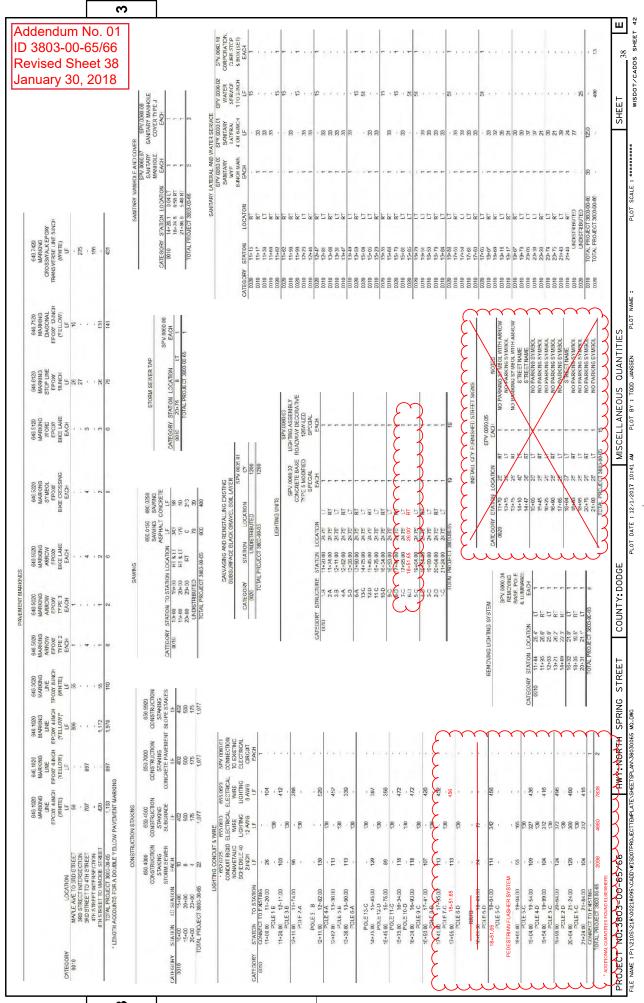

	<del>က</del>	ID 38 Revis	ndum No. 01 03-00-65 sed Sheet 40
		655.02 19-14 Ai 154 205 50 50 50 50 50 50 50 50 50 50 50 50 5	ary 30, 2018
		655 0230 5-14 AWG 5- 5- 50 50	
		FROM     TO       NORTH SFRING STREET A WACKIE STREET INTERSECTION       EXCB1       IOTAL PROJECT 3609-00-55       TOTAL PROJECT 3609-00-55       TOTAL PROJECT 3008-00-55       AL PROJECT 3008-00-55       AL PROJECT 3008-00-55	
	663.0140 24x42-NCH EACH 1 2	M T3 T3 WACKIE STREET INTERS 31 EX-SB7 30.11E T3809-00-65 TOTAL PROJECT 3809-00-65 SP 0106.05 LS 1	
S STEEL		CORY FROM FROM ON IN STREET & MACKIE EXCENTION NORTH SPRING STREET & MACKIE EXCENTION IN STREET & MACKIE & MA	
PULL BOXES STEEL	CATESORY NUMBER STATION LOCATION 0010 PBI 21+41.6 25.0 RT PB2 19+62.7 24.7 RT TDTAL PROJECT 3903-00-65	<ul> <li>NORTH SFRING STREE</li> <li>NORTH SFRING STREE</li> <li>EXCB</li> <li>EXCB<td></td></li></ul>	
	CATEGORY N 0010	CATEGORY 0010 CATEGORY 0010 TO TO	MICOLI ANEDIC AUANTTEC
		565.0600 DETECYOR WIRE 1504 1504 1504	
			L
	5°, , ,	BS: 0700 ELECOP LEAD IN CELECOR LEAD IN CABLE LF LF LF LF LF LF LF LF LF LF	
	652.0235 SCHEDULE 40 3-INCH LF 120 120	MEER         652.080C         655.0           MEER         LOODUT         LOO           LOODUT         CONDUT         LOO           Jerss         LF         LI           Jers         LF	F
ALLIC	* HEDULE 40 2-INCH 2- 1 1 212 212		0.M.C. 0.101
CONDUIT RIGID NONMETALLIC	652 4 652 6 SCHEDULE 40 2-INCH 2-INCH 1- 1 173 212	OFFEET SIZE ACKIE SIREET INTERSECTION 9.7 RT 6:x27 9.7 RT 6:x27 11.5 RT 6:x27 11.5 RT 6:x27 20.8 RT 6:x27	
	FROM TO EXPB-1 EX-PB3 EXPB3 PB1 EXPB3 PB1 PB1 PB2 PB2 TOTAL PRCJECT 3003-00-55 TOTAL PRCJECT 3003-00-55	IX-TON         OFFSET           SITAGET         SITAGET           SITAGET         SITAGET           SITAGET         SITAGET           SITAGET         SITAGET           19+56         11.5           19+56         11.5           19+56         11.5           19+56         11.5           19+56         11.5           19-50         11.6           PROLECT         20.8           PROLECT         20.65           PROLECT         2           PROLOH         L           S08-0.65         2           S08-0.66         2           S0.07         1           S0.06         1	
	CATEGORY FROM 0010 EXFB-1 EXPB9 1014 P01 1014 PCJECT 33 * ADDITIONAL QUANTITIES FOUND ELSEWHERE	LDDP     LDDP     STATON     OFFSET     SCE       NOMBER     STATON     OFFSET     SCE       NOR H SPRING STREET MACKIE     STREET MIERSECTION       31     21+77     8.1 ft     6x20       32     21+85     9.7 kT     6x20       33     21+71     18.1 ft     6x60       23     21+71     19.5 ft     6x61       24     19+55     11.5 kT     6x61       28     21+71     10.8 kT     6x20       NORTH SPRING STREET SMAPLE AVENUE INTERSECTION     UNDSTRIBUTED     101AL PROLECT 3803-00-65       101AL PROLECT 3803-00-65     17.1 T     1       10-79     17.1 T     1       10-71     107-1 PROLECT 3003-00-65     2       10-74     10.116.0 G     644.0101       64.0101     5PU     1       10-74     1     1	
	1. QUANTITIES		
	CATEGORY 0100 * ADDITIONAL		00 LECT NO. 2002 OF
		uuuu	

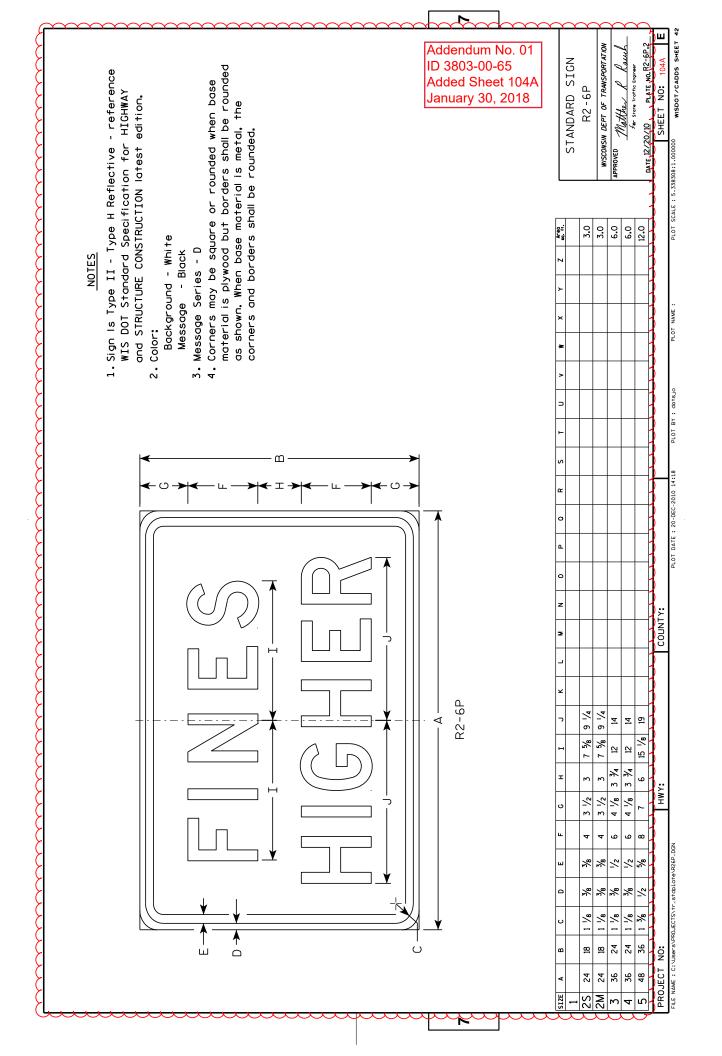



	Proposal Schedule of Items	Page 1 of 10
Proposal ID: 201802	3002 Project(s): 3803-00-65, 3803-00-66	
	Federal ID(s): WISC 2018081, N/A	
SECTION: 0001	Contract Item	
Alt Set ID:	Alt Mbr ID:	

Proposal Line Number	Item ID Description	Approximate Quantity and Units	Unit Price	Bid Amount
0002	201.0120 Clearing	148.000 ID		
0004	201.0220 Grubbing	148.000 ID		
0006	204.0100 Removing Pavement	2,093.000 SY		
0008	204.0150 Removing Curb & Gutter	1,529.000 LF	ii	i
0010	204.0155 Removing Concrete Sidewalk	1,306.000 SY	ii	i
0012	204.0210 Removing Manholes	8.000 EACH	·	i
0014	204.0220 Removing Inlets	10.000 EACH	ii	i
0016	204.0245 Removing Storm Sewer (size) 01. 6-Inch	50.000 LF	ii	i
0018	204.0245 Removing Storm Sewer (size) 02. 8-Inch	33.000 LF		
0020	204.0245 Removing Storm Sewer (size) 03. 10- Inch	70.000 LF		
0022	204.0245 Removing Storm Sewer (size) 04. 12- Inch	961.000 LF		
0024	204.0245 Removing Storm Sewer (size) 05. 18- Inch	80.000 LF		·
0026	204.0245 Removing Storm Sewer (size) 06. 24- Inch	305.000 LF	<u>.</u>	. <u></u>
0028	204.0280 Sealing Pipes	1.000 EACH		
0030	205.0100 Excavation Common	5,255.000 CY	<u></u>	



	Proposal Schedule of Items	Page 2 of 10
Proposal ID: 201802	3002 Project(s): 3803-00-65, 3803-00-66	
	Federal ID(s): WISC 2018081, N/A	
SECTION: 0001	Contract Item	
Alt Set ID:	Alt Mbr ID:	

Proposal Line Number	Item ID Description	Approximate Quantity and Units	Unit Price	Bid Amount
0032	213.0100 Finishing Roadway (project) 01. 3083- 00-65	1.000 EACH	<u>.</u>	·
0034	305.0120 Base Aggregate Dense 1 1/4-Inch	2,700.000 TON		
0036	311.0110 Breaker Run	5,550.000 TON		ii
0038	405.0100 Coloring Concrete WisDOT Red	30.000 CY		i
0040	405.1000 Stamping Colored Concrete	10.000 CY		ii
0042	415.0080 Concrete Pavement 8-Inch	4,900.000 SY		i
0044	416.0160 Concrete Driveway 6-Inch	400.000 SY	·	
0046	416.0610 Drilled Tie Bars	12.000 EACH	·	ii
0048	416.0620 Drilled Dowel Bars	20.000 EACH	·	ii
0050	465.0105 Asphaltic Surface	100.000 TON		i
0052	465.0120 Asphaltic Surface Driveways and Field Entrances	30.000 TON	·	·
0054	520.8000 Concrete Collars for Pipe	4.000 EACH	·	ii
0056	601.0409 Concrete Curb & Gutter 30-Inch Type A	850.000 LF		ii
0058	601.0411 Concrete Curb & Gutter 30-Inch Type D	200.000 LF		
0060	601.0452 Concrete Curb & Gutter Integral 30-Inch Type D	1,400.000 LF	·	;
0062	602.0405 Concrete Sidewalk 4-Inch	10,000.000 SF	. <u></u>	



	Proposal Schedule of Items	Page 3 of 10
Proposal ID: 2018021	13002 Project(s): 3803-00-65, 3803-00-66	
	Federal ID(s): WISC 2018081, N/A	
SECTION: 0001	Contract Item	
Alt Set ID:	Alt Mbr ID:	

Proposal Line Number	Item ID Description	Approximate Quantity and Units	Unit Price	Bid Amount
0064	602.0505 Curb Ramp Detectable Warning Field Yellow	104.000 SF		;
0066	608.0312 Storm Sewer Pipe Reinforced Concrete Class III 12-Inch	129.000 LF		<u> </u>
0068	608.0315 Storm Sewer Pipe Reinforced Concrete Class III 15-Inch	73.000 LF	. <u></u> .	;
0070	608.0318 Storm Sewer Pipe Reinforced Concrete Class III 18-Inch	35.000 LF	·	·
0072	608.0324 Storm Sewer Pipe Reinforced Concrete Class III 24-Inch	385.000 LF	·	<u> </u>
0074	608.2324 Storm Sewer Pipe Reinforced Concrete Horizontal Elliptical Class HE-III 24x38- Inch	794.000 LF		<u>.</u>
0076	611.0535 Manhole Covers Type J-Special	9.000 EACH		
0078	611.0624 Inlet Covers Type H	8.000 EACH	. <u></u>	<u>.</u>
0080	611.0639 Inlet Covers Type H-S	4.000 EACH	. <u></u>	
0082	611.0645 Inlet Covers Type MS-A	1.000 EACH	. <u></u>	. <u></u>
0084	611.1004 Catch Basins 4-FT Diameter	3.000 EACH	. <u></u>	. <u></u>
0086	611.1005 Catch Basins 5-FT Diameter	2.000 EACH		
0088	611.2004 Manholes 4-FT Diameter	2.000 EACH		
0090	611.2005 Manholes 5-FT Diameter	5.000 EACH		
0092	611.2006 Manholes 6-FT Diameter	2.000 EACH	<u>.</u>	



	Proposal Schedule of Items	Page 4 of 10
Proposal ID: 2018021	3002 Project(s): 3803-00-65, 3803-00-66	
	Federal ID(s): WISC 2018081, N/A	
SECTION: 0001	Contract Item	
Alt Set ID:	Alt Mbr ID:	

Proposal Line Number	Item ID Description	Approximate Quantity and Units	Unit Price	Bid Amount
0094	611.3230 Inlets 2x3-FT	7.000 EACH		i
0096	611.3901 Inlets Median 1 Grate	1.000 EACH		
0098	618.0100 Maintenance And Repair of Haul Roads (project) 01. 3803-00-65	1.000 EACH		·
0100	619.1000 Mobilization	1.000 EACH	;	
0102	624.0100 Water	55.000 MGAL	. <u></u>	
0104	625.0100 Topsoil	1,400.000 SY	iii	
0106	628.1905 Mobilizations Erosion Control	10.000 EACH	i	<u>.</u>
0108	628.1910 Mobilizations Emergency Erosion Control	5.000 EACH		
0110	628.7010 Inlet Protection Type B	1.000 EACH		
0112	628.7015 Inlet Protection Type C	25.000 EACH		
0114	628.7020 Inlet Protection Type D	7.000 EACH		
0116	631.0300 Sod Water	8.400 MGAL		
0118	631.1000 Sod Lawn	1,400.000 SY		
0120	637.2210 Signs Type II Reflective H	76.240 SF		
0122	637.2230 Signs Type II Reflective F	22.880 SF	·	
0124	638.2602 Removing Signs Type II	28.000 EACH	i	



	Proposal Schedule of Items	Page 5 of 10
Proposal ID: 20180213	3002 Project(s): 3803-00-65, 3803-00-66	
	Federal ID(s): WISC 2018081, N/A	
SECTION: 0001	Contract Item	
Alt Set ID:	Alt Mbr ID:	

Proposal Line Number	Item ID Description	Approximate Quantity and Units	Unit Price	Bid Amount
0126	638.3000 Removing Small Sign Supports	21.000 EACH		
0128	642.5001 Field Office Type B	1.000 EACH	<u>.</u>	
0130	643.0300 Traffic Control Drums	3,500.000 DAY		
0132	643.0410 Traffic Control Barricades Type II	2,000.000 DAY		
0134	643.0420 Traffic Control Barricades Type III	5,500.000 DAY		
0136	643.0800 Traffic Control Arrow Boards	150.000 DAY		
0138	643.0900 Traffic Control Signs	11,500.000 DAY		
0140	643.5000 Traffic Control	1.000 EACH		
0142	644.1420.S Temporary Pedestrian Surface Plywood	500.000 SF		
0144	644.1601.S Temporary Curb Ramp	15.000 EACH		
0146	644.1616.S Temporary Pedestrian Safety Fence	250.000 LF		
0148	646.1020 Marking Line Epoxy 4-Inch	4,058.000 LF		
0150	646.3020 Marking Line Epoxy 8-Inch	110.000 LF		
0152	646.5020 Marking Arrow Epoxy	14.000 EACH		
0154	646.5120 Marking Word Epoxy	6.000 EACH	. <u></u>	
0156	646.5220 Marking Symbol Epoxy	6.000 EACH		
0158	646.6120 Marking Stop Line Epoxy 18-Inch	79.000 LF		·



	Proposal Schedule of Items	Page 6 of 10
Proposal ID: 2018021	3002 Project(s): 3803-00-65, 3803-00-66	
	Federal ID(s): WISC 2018081, N/A	
SECTION: 0001	Contract Item	
Alt Set ID:	Alt Mbr ID:	

Proposal Line Number	Item ID Description	Approximate Quantity and Units	Unit Price	Bid Amount
0160	646.7120 Marking Diagonal Epoxy 12-Inch	141.000 LF		·
0162	646.7420 Marking Crosswalk Epoxy Transverse Line 6-Inch	431.000 LF	;	;
0164	650.4000 Construction Staking Storm Sewer	22.000 EACH	·	<u>.</u>
0166	650.4500 Construction Staking Subgrade	1,077.000 LF	·	
0168	650.7000 Construction Staking Concrete Pavement	1,077.000 LF		
0170	650.9910 Construction Staking Supplemental Control (project) 01. 3083-00-65	LS	LUMP SUM	<u> </u>
0172	650.9920 Construction Staking Slope Stakes	1,077.000 LF		
0174	652.0225 Conduit Rigid Nonmetallic Schedule 40 2-Inch	2,310.000 LF		
0176	652.0235 Conduit Rigid Nonmetallic Schedule 40 3-Inch	120.000 LF	·	<u> </u>
0178	652.0800 Conduit Loop Detector	432.000 LF		
0180	653.0140 Pull Boxes Steel 24x42-Inch	2.000 EACH	. <u></u>	
0182	654.0101 Concrete Bases Type 1	1.000 EACH	·	·
0184	655.0230 Cable Traffic Signal 5-14 AWG	50.000 LF		·
0186	655.0280 Cable Traffic Signal 19-14 AWG	409.000 LF		<u>.</u>
0188	655.0610 Electrical Wire Lighting 12 AWG	4,660.000 LF		



	Proposal Schedule of Items	Page 7 of 10
Proposal ID: 2018021	13002 Project(s): 3803-00-65, 3803-00-66	
	Federal ID(s): WISC 2018081, N/A	
SECTION: 0001	Contract Item	
Alt Set ID:	Alt Mbr ID:	

Proposal Line Number	Item ID Description	Approximate Quantity and Units	Unit Price	Bid Amount
0190	655.0620 Electrical Wire Lighting 8 AWG	7,838.000 LF		
0192	655.0700 Loop Detector Lead In Cable	828.000 LF		
0194	655.0800 Loop Detector Wire	1,864.000 LF		
0196	690.0150 Sawing Asphalt	600.000 LF		i
0198	690.0250 Sawing Concrete	400.000 LF		
0200	715.0415 Incentive Strength Concrete Pavement	1,470.000 DOL	1.00000	1,470.00
0202	ASP.1T0A On-the-Job Training Apprentice at \$5.00/HR	475.000 HRS	5.00000	2,375.00
0204	ASP.1T0G On-the-Job Training Graduate at \$5.00/HR	300.000 HRS	5.00000	1,500.00
0206	SPV.0035 Special 01. Salvaging and Reinstalling Existing Subsurface Black Gravel Soil Layer	1,200.000 CY	. <u></u>	
0208	SPV.0060 Special 01. Connection to Existing Electrical Circuit	2.000 EACH	. <u></u>	
0210	SPV.0060 Special 02. Concrete Base Type 5 Modified Special	19.000 EACH	. <u></u>	
0212	SPV.0060 Special 03. Lighting Assembly Roadway Decorative 126W-LED Special	19.000 EACH	;	
0214	SPV.0060 Special 04. Removing Base, Pole & Luminaire	8.000 EACH	·	<u>.</u>
0218	SPV.0060 Special 06. Storm Sewer Tap	1.000 EACH	. <u></u>	



	Proposal Schedule of Items	Page 8 of 10
Proposal ID: 2018021	3002 Project(s): 3803-00-65, 3803-00-66	
	Federal ID(s): WISC 2018081, N/A	
SECTION: 0001	Contract Item	
Alt Set ID:	Alt Mbr ID:	

Proposal Line Number	Item ID Description	Approximate Quantity and Units	Unit Price	Bid Amount
0220	SPV.0060 Special 07. Sanitary Manhole	3.000 EACH		<u>_</u>
0222	SPV.0060 Special 08. Sanitary Manhole Cover Type J	3.000 EACH		
0224	SPV.0060 Special 09. Sanitary Wye 8-Inch Main	36.000 EACH	. <u></u>	
0226	SPV.0060 Special 10. Corporation, Curb Stop & Box (Set)	13.000 EACH		
0228	SPV.0060 Special 11. Water Valve & Box 6-Inch	6.000 EACH	<u>.</u>	ii
0230	SPV.0060 Special 12. Water Valve & Box 10-Inch	6.000 EACH	. <u></u>	
0232	SPV.0060 Special 13. Fire Hydrant	2.000 EACH		
0234	SPV.0060 Special 14. Tees 10"X6"X10"	2.000 EACH		
0236	SPV.0060 Special 15. Crosses 10"X6"	2.000 EACH		<u>.</u>
0238	SPV.0060 Special 16. Bend 45-Degree 4-Inch	2.000 EACH		·
0240	SPV.0060 Special 17. Bend 11.25-Degree 6-Inch	4.000 EACH		<u> </u>
0242	SPV.0060 Special 18. Bend 45-Degree 6-Inch	4.000 EACH		
0244	SPV.0060 Special 19. Bend 45-Degree 10-Inch	4.000 EACH		<u> </u>
0246	SPV.0060 Special 20. Reducer 6"X4"	1.000 EACH		
0248	SPV.0060 Special 21. Utility Line Opening	10.000 EACH		
0252	SPV.0060 Special 23. U-Channel Sign Post 13 FT	4.000 EACH		



	Proposal Schedule of Items	Page 9 of 10
Proposal ID: 2018021	3002 Project(s): 3803-00-65, 3803-00-66	
	Federal ID(s): WISC 2018081, N/A	
SECTION: 0001	Contract Item	
Alt Set ID:	Alt Mbr ID:	

Proposal Line Number	Item ID Description	Approximate Quantity and Units	Unit Price	Bid Amount
0254	SPV.0060 Special 24. U-Channel Sign Post 14 FT	7.000 EACH	i	
0256	SPV.0060 Special 25. Connect Private Storm Sewer Pipe	6.000 EACH	·	
0258	SPV.0060 Special 26. Fluorocarbon Gaskets	10.000 EACH		
0260	SPV.0060 Special 27. Repair Existing Loop Detector	2.000 EACH		
0262	SPV.0090 Special 01. Sanitary Lateral 4-Inch or 6- Inch	1,250.000 LF	;	. <u></u>
0264	SPV.0090 Special 02. Water Service 1-Inch to 2- Inch	400.000 LF		·
0266	SPV.0090 Special 03. Sanitary Sewer Pipe 8-Inch	1,250.000 LF		·
0268	SPV.0090 Special 04. PVC Water Main 4-Inch	10.000 LF		
0270	SPV.0090 Special 05. PVC Water Main 6-Inch	250.000 LF	<u>.</u>	·
0272	SPV.0090 Special 06. PVC Water Main 10-Inch	1,040.000 LF		
0274	SPV.0090 Special 07. Ductile Iron Water Main 10- Inch	110.000 LF	. <u></u>	. <u></u>
0276	SPV.0090 Special 08. PVC Storm Sewer Pipe 6- Inch	35.000 LF		·
0278	SPV.0090 Special 09. PVC Storm Sewer Pipe 8- Inch	30.000 LF	<u>.</u>	·
0280	SPV.0090 Special 10. PVC Storm Sewer Pipe 10- Inch	50.000 LF		·



	Proposal Schedule of Items	Page 10 of 10
Proposal ID: 2018021	3002 Project(s): 3803-00-65, 3803-00-66	
	Federal ID(s): WISC 2018081, N/A	
SECTION: 0001	Contract Item	
Alt Set ID:	Alt Mbr ID:	

Proposal Line Number	Item ID Description	Approximate Quantity and Units	Unit Price	Bid Amount
0282	SPV.0090 Special 11. PVC Storm Sewer Pipe 12- Inch	25.000 LF		
0284	SPV.0105 Special 01. Removing Lighting Conduit & Wire	LS	LUMP SUM	
0286	SPV.0105 Special 02. Remove Existing Sanitary Structure	LS	LUMP SUM	·
0288	SPV.0105 Special 03. Remove Existing Water Structure	LS	LUMP SUM	·
0292	SPV.0105 Special 05. Repair Traffic Signal Conduit & Wiring	LS	LUMP SUM	·
0294	SPV.0195 Special 01. Excavation, Hauling, Dewatering and Disposal of Contaminated Soil	450.000 TON	·	
0296	SPV.0060 Special 28. U-Channel Sign Post 16-Ft	2.000 EACH		
0298	SPV.0105 Special 06. Pedestrian Flasher System	LS	LUMP SUM	
	Section: 000	)1	Total:	
			Total Bid:	·